


STATE OF KANSAS
STATE CORPORATION COMMISSION

WELL PLUGGING RECORD

Give All Information Completely
Make Required Affidavit
Mail or Deliver Report to
Conservation Division
State Corporation Comm.
245 North Water
Wichita, KS 67202

Stafford County. Sec. 12 Twp 24S Rge. 13 E/W
Location as "NE/CNW $\frac{1}{4}$ SW $\frac{1}{4}$ " or footage from lines
Approx C NW NW NW

Lease Owner Theodore I. Leben & Associates
Lease Name Garner Well No. 1
Office Address 210 Petroleum Bldg., Wichita, Ks. 67202
Character of Well (Completed as Oil, Gas or Dry Hole)
dry hole

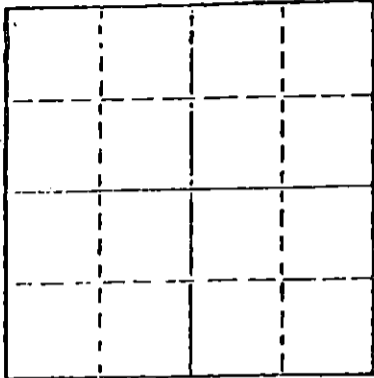

Locate well correctly on above
Section Plat

Date Well completed 6-11 19 78
Application for plugging filed 6-11 19 78
Application for plugging approved 6-11 19 78
Plugging commenced 6-11 19 78
Plugging completed 6-11 19 78
Reason for abandonment of well or producing formation
no commercial quantities of oil or gas encountered
If a producing well is abandoned, date of last production
 19

Was permission obtained from the Conservation Division or
its agents before plugging was commenced? yes

Name of Conservation Agent who supervised plugging of this well Bill Owens
Producing formation Depth to top Bottom Total Depth of Well 3885
Show depth and thickness of all water, oil and gas formations.

OIL, GAS OR WATER RECORDS

CASING RECORD

FORMATION	CONTENT	FROM	TO	SIZE	PUT IN	PULLED OUT
surface hole	shale	surf	286'	8-5/8	278'	none

Describe in detail the manner in which the well was plugged, indicating where the mud fluid
was placed and the method or methods used in introducing it into the hold. If cement or other
plugs were used, state the character of same and depth placed, from feet to
 feet for each plug set.

Fluid to 540', plug, 40 sx
Fluid to 240', plug, 35 sx
Fluid to 40', plug, 12 sx + 1/2 sx hulls
3 sx in rat hole

RECEIVED
STATE CORPORATION COMMISSION
JUN 14 1978
CONSERVATION DIVISION
Wichita, Kansas

(If additional description is necessary, use BACK of this sheet)

Name of Plugging Contractor D N B DRILLING, INC.
515 R. H. Garvey Building
Wichita, Kansas 67202

STATE OF Kansas COUNTY OF Sedgwick, ss.
Ella Priess (employee of owner) or (owner or operator)
of the above-described well, being first duly sworn on oath, says: That I have knowledge of
the facts, statements, and matters herein contained and the log of the above-described well
as filed and that the same are true and correct. So help me God.

(Signature) Ella Priess
Suite 515, R. H. Garvey Bldg., Wichita, Ks.
(Address) 67202

SUBSCRIBED AND SWORN TO before me this 12th day of June, 1978

Dorothy L. Schmidt
Dorothy L. Schmidt Notary Public.

My commission expires 4/30/79

DOROTHY L. SCHMIDT
STATE NOTARY PUBLIC
Sedgwick County, Kansas
My Appt. Exp. April 30, 1979

DRILLERS' LOG

THEODORE I. LEBEN & ASSOCIATES

No. 1 Garner
Approx C NW NW NW
Sec. 12-24S-13W
Stafford Co., Ks.Commenced: 6-2-78
Completed: 6-11-78Surface Casing: 278' of 8-5/8"
cemented w/250 sx common, 2% gel, 3% cc
6-3-78FORMATIONDEPTH

Surface Hole	0 - 286
Shale	286 - 1445
Shale & Lime	1445 - 2290
Lime & Shale	2290 - 2565
Shale & Lime	2565 - 2875
Lime & Shale	2875 - 3360
Shale & Lime	3360 - 3475
Lime & Shale	3475 - 3575
Lime	3575 - 3685 RTD

RECEIVED
CONSERVATION COMMISSION

JUN 14 1978

CONSERVATION DIVISION
Wichita, Kansas

I do hereby certify that the foregoing statements are true and correct to the best of my knowledge and belief.

D N B DRILLING, INC.

Ella Priess
Ella Priess

STATE OF KANSAS: ss:

Subscribed and sworn to before me this 12th day of June, 1978.

Dorothy L. Schmidt
Dorothy L. Schmidt, Notary Public

DOROTHY L. SCHMIDT
STATE NOTARY PUBLIC
Sedgwick County, Kansas
My App. Exp. April 30, 1979