


WELL PLUGGING RECORD

Give All Information Completely  
Make Required Affidavit  
Mail or Deliver Report to:  
Conservation Division  
State Corporation Commission  
211 No. Broadway  
Wichita, Kansas

KINGMAN County, Sec. 36 Twp. 30S Rge. 8W (X) (W)  
NW NE SW

Location as "NE/CNW/SW" or footage from lines  
Lease Owner PETROLEUM, INC.  
Lease Name DAUNER Well No. 1  
Office Address ROUTE 2, GREAT BEND, KANSAS  
Character of Well (completed as Oil, Gas or Dry Hole) DRY HOLE  
Date well completed FEBRUARY 22, 1963  
Application for plugging filed FEBRUARY 22, 1963  
Application for plugging approved FEBRUARY 22, 1963  
Plugging commenced FEBRUARY 22, 1963  
Plugging completed FEBRUARY 22, 1963  
Reason for abandonment of well or producing formation NO PRODUCIBLE ZONES

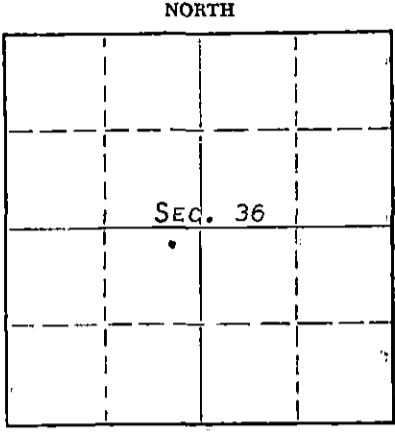

Locate well correctly on above Section Plat

If a producing well is abandoned, date of last production NONE 19  
Was permission obtained from the Conservation Division or its agents before plugging was commenced? YES

Name of Conservation Agent who supervised plugging of this well W. L. LACKAMP, JR.  
Producing formation --- Depth to top --- Bottom --- Total Depth of Well 4485 Feet  
Show depth and thickness of all water, oil and gas formations.

OIL, GAS OR WATER RECORDS

CASING RECORD

FORMATION	CONTENT	FROM	TO	SIZE	PUT IN	PULLED OUT
				8-5/8"	253'	NONE

Describe in detail the manner in which the well was plugged, indicating where the mud fluid was placed and the method or methods used in introducing it into the hole. If cement or other plugs were used, state the character of same and depth placed, from feet to feet for each plug set.

MUDDED UP WITH HEAVY MUD TO 180' FOLLOWED BY WOODEN PLUG AND 1/4 SACK HULLS. PLACED 20 SACKS CEMENT THROUGH DRILL PIPE ONTO HULLS. MUDDED UP WITH HEAVY MUD TO 40', FOLLOWED BY WOODEN PLUG, 1/4 SACK HULLS AND 10 SACKS CEMENT TO BASE OF WELL CELLAR. PLUGGED RAT HOLE WITH 2 SACKS CEMENT.

RECEIVED  
STATE CORPORATION COMMISSION

MAR 4 1963  
3-4-63  
CONSERVATION DIVISION  
Wichita, Kansas

(If additional description is necessary, use BACK of this sheet)  
Name of Plugging Contractor GARVEY DRILLING COMPANY  
Address ROUTE 2, GREAT BEND, KANSAS

STATE OF KANSAS, COUNTY OF BARTON, ss.  
DON SEARLE (employee of owner) or (operator) of the above-described

well, being first duly sworn on oath, says: That I have knowledge of the facts, statements, and matters herein contained and the log of the above-described well as filed and that the same are true and correct. So help me God.

(Signature) DON SEARLE, DIST. PROD. SUPT.  
ROUTE 2, GREAT BEND, KANSAS  
(Address)

SUBSCRIBED AND SWORN TO before me this 28TH day of FEBRUARY, 1963

My commission expires APRIL 14, 1963

Arthur J. [Signature] Notary Public.

# WELL LOG

COMPANY Petroleum Inc

SEC. 36 T. 30S R. 8W

FARM Dauner

NO. 1

LOC. NW NE SW


TOTAL DEPTH 4485'

COUNTY Kingman

COMM. 2-9-63

COMP. 2-22-63

CONTRACTOR

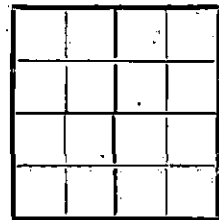

CASING 8 5/8" @ 253' w/175 sx

ELEVATION 1646' D.F.

PRODUCTION D & A

FIGURES INDICATE BOTTOM OF FORMATIONS

- 130' Surface Soil and Sand
- 254' Red Bed
- 1460' Shale and Shells
- 1500' Shale and Lime Shells
- 2200' Lime
- 3700' Shale and Lime
- 3900' Lime and Shale
- 4405' Lime
- 4460' Mississippi Chert
- 4485' Mississippi
- 4485' RTD

RECEIVED  
STATE CORPORATION COMMISSION

MAR 4 1963

CONSERVATION DIVISION  
Wichita, Kansas

State of Kansas

County of Barton

SS

I, Sam N. Stephens of Garvey Drilling Company

upon oath state the above and foregoing is a true and correct copy of the log of the \_\_\_\_\_ well.

Sam N. Stephens

Subscribed and sworn to before me this 27th day of February 19 63

My Commission Expires: April 14th, 1963

Arthur J. Mills

NOTARY PUBLIC