


15.167.30245.00.00

STATE OF KANSAS
STATE CORPORATION COMMISSION

Give All Information Completely
Make Required Affidavit
Mail or Deliver Report to:
Conservation Division
State Corporation Commission
212 No. Market
Wichita, Kansas

WELL PLUGGING RECORD

NORTH

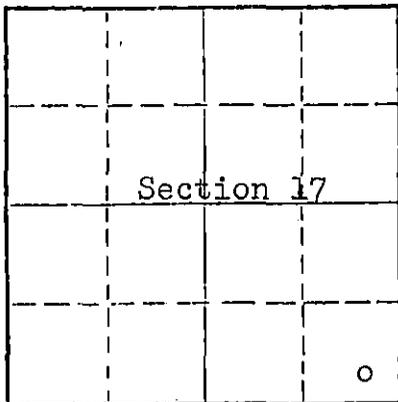

Locate well correctly on above
Section Plat

Russell County, Sec 17 Twp. 14S Rge. 13 (E) 13 (W)
Location as "NE/CNW/SW" or footage from lines SE SE SE
Lease Owner CRA, Inc.
Lease Name Rein Well No. 1-A
Office Address Drawer "C", Great Bend, Kansas
Character of Well (completed as Oil, Gas or Dry Hole) Dry Hole
Date well completed 9-7- 19 66
Application for plugging filed 2-27- 19 67
Application for plugging approved 2-28- 19 67
Plugging commenced 2-28- 19 67
Plugging completed 3-2- 19 67
Reason for abandonment of well or producing formation No commercial
producing zones
If a producing well is abandoned, date of last production --- 19 ---
Was permission obtained from the Conservation Division or its agents before plugging was commenced? Yes

Name of Conservation Agent who supervised plugging of this well Don Truan, Russell, Kansas
Producing formation --- Depth to top --- Bottom --- Total Depth of Well 3281 Feet
Show depth and thickness of all water, oil and gas formations.

OIL, GAS OR WATER RECORDS

CASING RECORD

FORMATION	CONTENT	FROM	TO	SIZE	PUT IN	PULLED OUT
				8-5/8"	530'	None
				4-1/2"	3280'	2535'

Describe in detail the manner in which the well was plugged, indicating where the mud fluid was placed and the method or methods used in introducing it into the hole. If cement or other plugs were used, state the character of same and depth placed, from _____ feet to _____ feet for each plug set.

Plugged off bottom of hole with sand to 3265' and capped with 4 sacks common cement to 3215'. Mudded up with heavy mud to 300' followed by 15' rock bridge and capped with 4 yards of ready mix common cement to base of well cellar.

STATE CORPORATION COMMISSION
WICHITA, KANSAS

MAR 9 1967

CONSERVATION DIVISION
Wichita, Kansas

(If additional description is necessary, use BACK of this sheet)

Name of Plugging Contractor Ralph Comstock
Address Stafford, Kansas

STATE OF Kansas, COUNTY OF Barton, ss.
Joseph D. Alcott (employee of owner) or (owner or operator) of the above-described well, being first duly sworn on oath, says: That I have knowledge of the facts, statements, and matters herein contained and the log of the above-described well as filed and that the same are true and correct. So help me God.

(Signature) J. D. Alcott
Drawer "C", Great Bend, Kansas 67530
(Address)

SUBSCRIBED AND SWORN to before me this 8th day of March, 19 67

Ruth Pound
Ruth Pound, Notary Public.

My commission expires August 10, 1968

KANSAS GEOLOGICAL SOCIETY
KANSAS WELL LOG BUREAU - KANSAS WELL SAMPLE BUREAU
KANSAS GEOLOGICAL SOCIETY BUILDING
508 EAST MURDOCK - WICHITA, KANSAS


COMPANY CRA Inc.

SEC. 17 T. 14S R. 13W
 LOC. SE SE SE

FARM Rein NO. #1-A

TOTAL DEPTH 3281
 COMM. August 19, 1966 COMP. August 27, 1966
 SHOT OR TREATED
 CONTRACTOR Woodman & Iannitti Drilling Company
 ISSUED

COUNTY Russell
 KANSAS

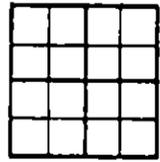

CASING
 20 10
 15 8 5/8 @ 530'
 12 6
 13 5
 4 1/2 @ 3278 1/2
FIGURES INDICATE BOTTOM OF FORMATIONS

ELEVATION

PRODUCTION

40 Post Rock
 185 Shale & Post Rock
 345 Red Bed Shale & Shells
 375 Soft Sand
 390 Hard Sand
 405 Hard Sand
 460 Sand & Shale
 500 Shale
 535 Red Bed
 801 Red Bed
 836 Anhy
 870 Shale & Shells
 1490 Shale & Shells
 1540 Lime & Shale
 1680 Lime
 1840 Lime
 1947 Lime
 2110 Lime
 2310 Lime & Shale
 2495 Lime & Shale
 2635 Lime
 2760 Lime
 2825 Lime
 2915 Lime
 3000 Lime
 3050 Lime
 3115 Lime
 3154 Lime
 3225 Lime
 3272 Lime
 3281 Lime
 3281 Total Depth

RECEIVED
 STATE CORPORATION COMMISSION
 FEB 28 1967
 CONSERVATION DIVISION
 Wichita, Kansas

I certify the above to be a true and correct copy of the driller's log and the geological tops to the best of my knowledge and belief.

Woodman & Iannitti Drilling Company

K. T. Woodman
 K. T. Woodman