


STATE OF KANSAS  
STATE CORPORATION COMMISSION

Give All Information Completely  
Make Required Affidavits  
Mail or Deliver Reports:  
Conservation Division  
State Corporation Commission  
800 Bittling Building  
Wichita, Kansas

15-167-0039-00-00  
WELL PLUGGING RECORD

NO. H

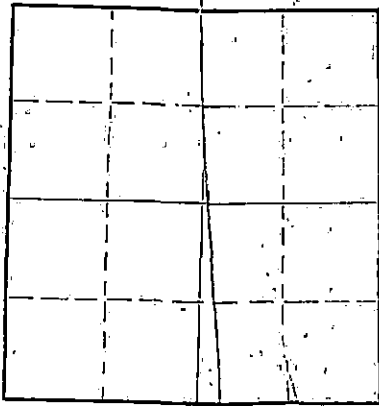

Locate well correctly on above Section Plat

Russell County. Sec. 17 Twp. 14S. Rge. (E) 15 (W)  
Location as "NE/CNW $\frac{1}{4}$ /SW $\frac{1}{4}$ " or footage from lines SE SE SE  
Lease Owner M. B. Armer  
Lease Name Wm. J. Smith Well No. 1  
Office Address 306 Insurance Building  
Character of Well (completed as Oil, Gas or Dry Hole) dry hole  
Date well completed 11/4 1949  
Application for plugging filed 11/4 1949  
Application for plugging approved 11/4 1949  
Plugging commenced 11/4 1949  
Plugging completed 11/4 1949  
Reason for abandonment of well or producing formation dry

If a producing well is abandoned, date of last production 19  
Was permission obtained from the Conservation Division or its agents before plugging was commenced? yes

Name of Conservation Agent who supervised plugging of this well Eldon Petty  
Producing formation Arbuckle - dry Depth to top 3329 Bottom 3347 Total Depth of Well 3347 Feet  
Show depth and thickness of all water, oil and gas formations.

OIL, GAS OR WATER RECORDS

CASING RECORD

| Formation   | Content | From | To   | Size   | Put In | Pulled Out |
|-------------|---------|------|------|--------|--------|------------|
| Kansas City | dry     | 3057 | 3300 | 8-5/8" | 159'   | none       |
| Arbuckle    | dry     | 3329 | 3347 |        |        |            |

Describe in detail the manner in which the well was plugged, indicating where the mud fluid was placed and the method or methods used in introducing it into the hole. If cement or other plugs were used, state the character of same and depth placed, from feet to feet for each plug set:

Filled hole with heavy rotary mud from 3347 ft. to 159 ft., set wood plug and 20 sacks cement. Rotary mud to 30 ft., set wood plug and 10 sacks cement at surface.

11-10-49

RECEIVED  
CONSERVATION DIV.  
NOV 10 1949  
STATE CORPORATION COMMISSION  
KANSAS

Correspondence regarding this well should be addressed to M. B. Armer  
Address 306 Insurance Building, Wichita 2, Kansas

STATE OF Kansas COUNTY OF Sedgwick, ss.

L. C. Sponenberg (employee of owner) Notary Public of the above-described well,  
being first duly sworn on oath, says: That I have knowledge of the facts, statements, and matters herein contained and the log of the above-described well as filed and that the same are true and correct. So help me God.

(Signature) *L. C. Sponenberg*  
306 Insurance Bldg., Wichita, Kansas  
(Address)

SUBSCRIBED AND SWORN to before me this 9th day of November, 1949

My commission expires Sept. 17, 1951  
*Regil Walton* Notary Public

LOG

Company: M. B. Armer  
 Contractor: Armer Drilling Company, Inc.  
 Drilling commenced: 10/21/49  
 Drilling completed: 11/5/49  
 Elev: 1830 D. P.  
 1827 Gr.  
 (Rotary #1)

Farm: William J. Smith - well #1  
 Location: SE SE Sec. 17-14S-15W,  
 Russell County, Kansas  
 Casing record: 8-5/8" set @ 159'  
 v/95 sacks cement

(figures below indicate bottoms)

|                    |            |
|--------------------|------------|
| Rig                | 5          |
| Cellar             | 10         |
| Shale              | 35         |
| Sand               | 70         |
| Shale & shells     | 465        |
| Sand               | 530        |
| Red bed            | 705        |
| Shale & shells     | 890        |
| Anhydrite & shale  | 935        |
| Shale & shells     | 1655       |
| Shale & lime       | 2120       |
| Shale & shells     | 2350       |
| Lime & shale       | 2585       |
| Lime               | 2630       |
| Shale & lime       | 2793       |
| Lime               | 2885       |
| Lime & shale       | 2945       |
| Lime               | 3098       |
| Lime - total depth | 3347 D & A |

FORMATION TOPS:

|                   |      |
|-------------------|------|
| Topeka            | 2747 |
| Heebner           | 3010 |
| Toronto           | 3027 |
| Kansas City       | 3057 |
| Base Kansas City  | 3300 |
| Sand Conglomerate | 3311 |
| Arbuckle          | 3329 |

I hereby certify that this is a true and correct log of the above described well as shown by the drilling reports.

RECEIVED

NOV 10 1949

ARMER DRILLING COMPANY, INC.  
STATE REGISTRATION

COMMISSION  
KANSAS

By L. L. Spinning

STATE OF KANSAS )  
                          ) SS  
COUNTY OF SEDGWICK )

Subscribed and sworn to before me, a notary public, in and for said County and State this 6th day of November, 1949.

Walter Walton  
Notary Public

My commission expires Sept. 17, 1951