

15.167.30309.00.00

STATE OF KANSAS  
STATE CORPORATION COMMISSION


Form CP-4

WELL PLUGGING RECORD

Give All Information Completely  
Make Required Affidavit  
Mail or Deliver Report to:  
Conservation Division  
State Corporation Commission  
212 No. Market  
Wichita, Kansas

Russell County, Sec. 36 Twp. 14 Rge. 13 (E) (W)  
Location as "NE/CNW/SW" or footage from lines N<sup>1</sup>/<sub>2</sub> N<sup>1</sup>/<sub>2</sub> NE<sup>1</sup>/<sub>4</sub>

NORTH

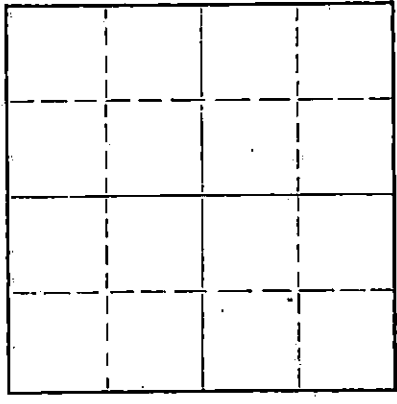

Locate well correctly on above  
Section Plat

Lease Owner Texaco, Inc.  
Lease Name E. Z. Rube Well No. 6  
Office Address 614 Bitting Building Wichita, Kansas  
Character of Well (completed as Oil, Gas or Dry Hole) \_\_\_\_\_  
Date well completed \_\_\_\_\_ 19\_\_\_\_  
Application for plugging filed \_\_\_\_\_ 19\_\_\_\_  
Application for plugging approved \_\_\_\_\_ 19\_\_\_\_  
Plugging commenced 1-11-67 19\_\_\_\_  
Plugging completed 1-14-67 19\_\_\_\_  
Reason for abandonment of well or producing formation \_\_\_\_\_

If a producing well is abandoned, date of last production \_\_\_\_\_ 19\_\_\_\_  
Was permission obtained from the Conservation Division or its agents before plugging was commenced? DONALD TRUAN

Name of Conservation Agent who supervised plugging of this well \_\_\_\_\_  
Producing formation \_\_\_\_\_ Depth to top \_\_\_\_\_ Bottom \_\_\_\_\_ Total Depth of Well 3000 Feet  
Show depth and thickness of all water, oil and gas formations.

OIL, GAS OR WATER RECORDS

CASING RECORD

FORMATION	CONTENT	FROM	TO	SIZE	PUT IN	PULLED OUT
				8 5/8	287	None
				5 1/2	None	2305

Describe in detail the manner in which the well was plugged, indicating where the mud fluid was placed and the method or methods used in introducing it into the hole. If cement or other plugs were used, state the character of same and depth placed, from \_\_\_\_\_ feet to \_\_\_\_\_ feet for each plug set.

Moved in. Rigged up unit. Made up bailer. Ran bailer to bottom.  
Pushed plug to 2800'. Poured 5 gal of egg rock on plug. Dug cellar.  
Unpacked head.

Mixed and dumped 5 sacks of cement on sand bridge at 2795'. Rigged  
up jacks. Worked casing - had 19" tension at 100,000# pressure.  
Cleared hole for shot. Shot pipe at 2402' - no change in tension.  
Shot pipe at 2306'.

Pulled 71 joints of 5 1/2" casing.

Halliburton squeezed well. Pumped 20 sacks of gel mud and 90 sacks  
of common cement. Broke off braden head. Cleaned threads. Put on  
protectors.

RECEIVED  
JAN 18 1967  
CONSERVATION DIVISION  
Wichita, Kansas

(If additional description is necessary, use BACK of this sheet)

Name of Plugging Contractor Forbes Casing Pulling, Inc.  
Address P. O. Box 221 Great Bend, Kansas

STATE OF Kansas, COUNTY OF Barton, ss.  
J. O. Forbes (employee of owner) or (owner or operator) of the above-described  
well, being first duly sworn on oath, says: That I have knowledge of the facts, statements, and matters herein contained and the log of the  
above-described well as filed and that the same are true and correct. So help me God.

(Signature) J. O. Forbes  
P. O. Box 221 Great Bend, Kansas  
(Address)

SUBSCRIBED AND SWORN TO before me this 16 day of January, 1967

My commission expires May 27, 1969

Clair [Signature]

Notary Public.

15 167-30309.00:00

# WELL LOG

COMPANY Texaco, Inc.

SEC. 36 T. 14S R. 13W  
LOC. N/2 N/2 NE/4

FARM E. Z. Ruby NO. Six

RIG. NO. 11

TOTAL DEPTH 3000'

COMM. 12-2-66

COMP. 12-9-66


COUNTRY Russell- Kansas  
KANSAS

SHOT OR TREATED

CONTRACTOR

Murfin Drilling Company

ISSUED

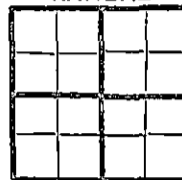

CASING

20	10	
15	8	5/8" w/215 sacks
12	6	
13	4	1/2" w/100 sacks

ELEVATION

PRODUCTION Oil

FIGURES INDICATE BOTTOM OF FORMATIONS

160	Shale
287	Pyrite & Red Bed
330	Shale
609	Shale & Red Bed
640	Anhydrite
1275	Shale - Shells
1475	Shale - Broken Lime
1685	Shale - Lime
1995	Lime - Shale
2335	Shale - Lime
2520	Lime & Shale
2585	Shale - Lime
2657	Lime - Shale
3000	Lime
3000	RTD

**RECEIVED**  
STATE CORPORATION COMMISSION  
JAN 11 1967  
CONSERVATION DIVISION  
Wichita, Kansas

State of KANSAS

County of SEDGWICK

ss:

I, W. R. Murfin of the Murfin Drilling Company

upon oath state that the above and foregoing is a true and correct copy of the log of the E. Z. Ruby #6 well.

W. R. Murfin  
W. R. Murfin

Subscribed and sworn to before me this 14th day of December 19 66

My Commission Expires: ADELA MIZENER, Notary Public

My commission expires November 5, 1970

Adela Mizener  
NOTARY PUBLIC