


STATE OF KANSAS
STATE CORPORATION COMMISSION

Give All Information Completely
Make Required Affidavit
Mail or Deliver Report to:
Conservation Division
State Corporation Commission
800 Bittig Building
Wichita, Kansas

WELL PLUGGING RECORD

NORTH

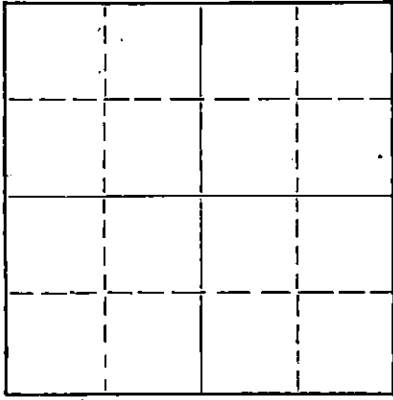

Locate well correctly on above
Section Plat

Kingman County. Sec. 16 Twp. 30 Rge. 8 (EX) (W)
Location as "NE/CNW/SW" or footage from lines NE SW NE
Lease Owner Sohio Petroleum Company
Lease Name L. M. Wells Well No. 1-A
Office Address Russell, Kansas
Character of Well (completed as Oil, Gas or Dry Hole) Dry
Date well completed 9-19- 1955
Application for plugging filed 9-19- 1955
Application for plugging approved 9-19- 1955
Plugging commenced 9-18- 1955
Plugging completed 9-19- 1955
Reason for abandonment of well or producing formation Dry

If a producing well is abandoned, date of last production _____ 19____
Was permission obtained from the Conservation Division or its agents before plugging was commenced? Yes

Name of Conservation Agent who supervised plugging of this well _____
Producing formation _____ Depth to top _____ Bottom _____ Total Depth of Well 1300 Feet
Show depth and thickness of all water, oil and gas formations.

OIL, GAS OR WATER RECORDS

CASING RECORD

| FORMATION | CONTENT | FROM | TO | SIZE | PUT IN | PULLED OUT |
|-----------|---------|------|----|--------|--------|------------|
| | | | | 8-5/8" | 301' | None |
| | | | | | | |
| | | | | | | |
Describe in detail the manner in which the well was plugged, indicating where the mud fluid was placed and the method or methods used in introducing it into the hole. If cement or other plugs were used, state the character of same and depth placed, from _____ feet to _____ feet for each plug set.

1300-220' Heavy Mud.
220-30' Wood plug, 30 sacks cement & Mud.
30'-Cellar Wood Plug, 10 sacks cement.

(If additional description is necessary, use BACK of this sheet)

Name of Plugging Contractor Garvey Drilling Company
Address Wichita, Kansas

STATE OF Kansas, COUNTY OF Russell, ss.
J. H. Bond (employee of owner) of the above-described well, being first duly sworn on oath, says: That I have knowledge of the facts, statements, and matters herein contained and the log of the above-described well as filed and that the same are true and correct. So help me God.

(Signature) J. H. Bond
(Address) _____

SUBSCRIBED AND SWORN TO before me this 20th day of September, 19 55

Leicester Brown
Notary Public.

My commission expires January 24, 1959

PLUGGING
FILE SEC. 16 TWP. 30 R. SW
BOOK PAGE 2 LINE 11

RECEIVED
STATE CORPORATION COMMISSION
SEP 21 1955
7-21-55
CONSERVATION
Wichita, K.

WELL LOG

COMPANY **Sohio Petroleum Company**

SEC. 16 T. 30SR. 8W

FARM **L. M. Wells**

NO. 1

LOC. NE SW NE


TOTAL DEPTH **4300'**

COUNTY **Kingman**

COMM. **September 2, 1955**

COMP. **September 19, 1955**

CONTRACTOR **Garvey Drilling Company**

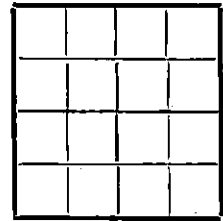

CASING **8-5/8" @ 304'**

ELEVATION **Unknown**

PRODUCTION **Unknown**

FIGURES INDICATE BOTTOM OF FORMATIONS

| | |
|------|--------------------|
| 30 | Sand |
| 570 | Red Rock & Shale |
| 975 | Shale & Shells |
| 1175 | Shale |
| 2939 | Shale & Lime |
| 3196 | Lime |
| 3278 | Sand & Shale |
| 3385 | Sand, Shale & Lime |
| 3391 | Lime |
| 3443 | Lime & Shale |
| 4010 | Lime |
| 4051 | Lime & Shale |
| 4189 | Lime |
| 4300 | Mississippi |
| 4300 | T. D. |

PLUGGING
 FILE SEC-16 T-30 R-26W
 BOOK PAGE 2 LINE 11

State of Kansas }
 County of Sedgwick } SS:

I, Eric Jager of Garvey Drilling Company

upon oath state that the above and foregoing is a true and correct copy of the log of the #1 L. M. Wells well

Subscribed and sworn to before me this 26th day of September 1955

My Commission Expires: August 9, 1959

RECEIVED
 STATE CORPORATION COMMISSION
 OCT 7 - 1955
 CONSERVATION DIVISION

Eric Jager
Elmer Monson
 NOTARY PUBLIC