


### WELL PLUGGING RECORD

Give All Information Completely  
Make Required Affidavit  
Mail or Deliver Report to:  
Conservation Division  
State Corporation Commission  
Biting Building  
Wichita, Kansas

Kingman County. Sec. 16 Twp. 30S Rge. 8W (E) (W)  
 Location as "NE/CNW $\frac{1}{4}$ SW $\frac{1}{4}$ " or footage from lines NW NW NW  
 Lease Owner Bachus Oil Company  
 Lease Name Wells "A" Well No. 1  
 Office Address 721 E. Central, Wichita, Kansas  
 Character of Well (completed as Oil, Gas or Dry Hole) Oil  
 Date well completed 2/1/57 19  
 Application for plugging filed 19  
 Application for plugging approved 10/28/70 19  
 Plugging commenced 10/28/70 19  
 Plugging completed 11/1/70 19  
 Reason for abandonment of well or producing formation Depleted  
 If a producing well is abandoned, date of last production 10/28/70 19  
 Was permission obtained from the Conservation Division or its agents before plugging was commenced? Yes

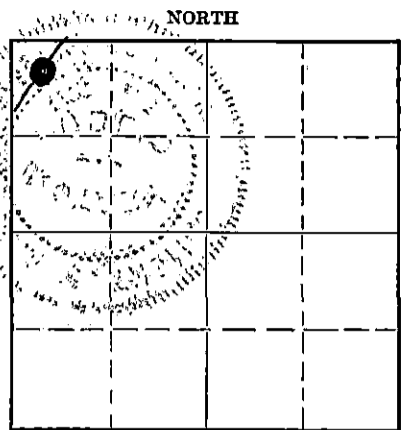

Locate well correctly on above Section Plat

Name of Conservation Agent who supervised plugging of this well G. Russell Biberstein  
 Producing formation Mississippian Depth to top 4164 Bottom 4260 Total Depth of Well 4260 Feet  
 Show depth and thickness of all water, oil and gas formations.

#### OIL, GAS OR WATER RECORDS

#### CASING RECORD

Formation	Content	From	To	Size	Put In	Pulled Out
Mississippian	Oil & Gas	-0- 4164	291 4230	8 5/8 5 1/2	291 4258	-0- 3087

Describe in detail the manner in which the well was plugged, indicating where the mud fluid was placed and the method or methods used in introducing it into the hole. If cement or other plugs were used, state the character of same and depth placed, from \_\_\_\_\_ feet to \_\_\_\_\_ feet for each plug set.

Filled hole with chat from 4260 to 4150  
 Dumped 5 sacks of cement and filled hole from 4150 to 4115  
 Ripped pipe at 3600, 3500, 3200 and 3160  
 Build 10' of rock bridge at 270  
 Fill hole from 270 to top with 4 1/2 yards of Ready Mix

RECEIVED  
 STATE CORPORATION COMMISSION  
 NOV 23 1970  
 CONSERVATION DIVISION  
 Wichita, Kansas  
 11-23-70

Plugged by Clarke Corporation, Medicine Lodge, Kansas

(If additional description is necessary, use BACK of this sheet)


Correspondence regarding this well should be addressed to Bachus Oil Company  
 Address 721 E. Central, Wichita, Kansas

STATE OF KANSAS, COUNTY OF Sedgwick, ss.  
 D. Bachus (employee of owner) or (owner or operator) of the above-described well,

being first duly sworn on oath, says: That I have knowledge of the facts, statements, and matters herein contained and the log of the above-described well, and that the same are true and correct. So help me God.

(Signature) *[Signature]*  
 D. Bachus  
 721 E. Central, Wichita, Kansas  
 (Address)

Subscribed and sworn to before me this 20th day of November, 1970

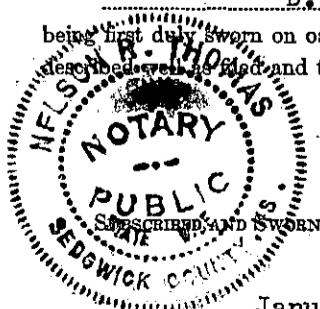

*[Signature]*  
 Nelson R. Thomas  
 Notary Public.

My commission expires January 26, 1973

ROTARY DRILLING LOG

15-095-00245-0000

OPERATOR: Bachus Oil Company  
 Wells No. 1  
 NW NW NW Sec. 16-30S-8W,  
 Kingman County, Kansas

CONTRACTOR: Prime Drilling Company  
 COMM: 11/1/56  
 COMP: 11/16/56

Remarks: Set 8-5/8" surface pipe  
 at 291' with 225 sacks Pozmix, 2%  
 C.C.

Formations

Sand & Clay	50'
Red Rock & Shale	200'
Red Rock	291'
Red Bed & Shale	650'
Shale & Shell	845'
Shale	980'
Anhydrite	1010'
Shale & Shells	1285'
Shale & Lime	1810'
Sandy Shale & Lime	1935'
Shale & Lime	2785'
Lime	2905'
Lime & Shale	3475'
Lime	3618'
Lime & Shale	3715'
Lime	3785'
Lime & Shale	3805'
Lime	4094'
Sandy Lime & Shale	4135'
Lime	4179'
Chat	4232'
Cherty Lime	4260'
Rotary Total Depth	4260'

RECEIVED  
 STATE CORPORATION COMMISSION  
 OCT 28 1970  
 CONSERVATION DIVISION  
 Wichita, Kansas

Set 5-1/2" casing at 4258' cemented  
 with 150 sacks cement.

We certify the above log is true and  
 correct to the best of our knowledge  
 and belief.

PRIME DRILLING COMPANY

*R.R. McNicol*

R. R. McNicol