


STATE OF KANSAS
STATE CORPORATION COMMISSION

WELL PLUGGING RECORD

Give All Information Completely
Make Required Affidavit
Mail or Deliver Report to:
Conservation Division
State Corporation Commission
211 No. Broadway
Wichita, Kansas

Kingman County. Sec. 19 Twp. 30 Rge. 8 (E) W. (W)
Location as "NE/CNW/SW4" or footage from lines 50' NE of Cen. NW NE
Lease Owner Cities Service Oil Company
Lease Name Richardson "A" Well No. 1
Office Address Box 308, Great Bend, Kansas
Character of Well (completed as Oil, Gas or Dry Hole) Dry Hole
Date well completed December 14, 1964
Application for plugging filed December 15, 1964
Application for plugging approved December 15, 1964
Plugging commenced December 15, 1964
Plugging completed December 15, 1964
Reason for abandonment of well or producing formation Non-commercial

NORTH

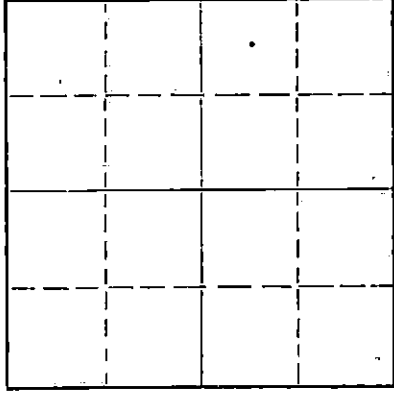

Locate well correctly on above
Section Plat

If a producing well is abandoned, date of last production - 19
Was permission obtained from the Conservation Division or its agents before plugging was commenced? Yes

Name of Conservation Agent who supervised plugging of this well Archie Elving
Producing formation _____ Depth to top _____ Bottom _____ Total Depth of Well 4270 Feet
Show depth and thickness of all water, oil and gas formations.

OIL, GAS OR WATER RECORDS

CASING RECORD

FORMATION	CONTENT	FROM	TO	SIZE	PUT IN	PULLED OUT
				8-5/8"	411'	None

Describe in detail the manner in which the well was plugged, indicating where the mud fluid was placed and the method or methods used in introducing it into the hole. If cement or other plugs were used, state the character of same and depth placed, from _____ feet to _____ feet for each plug set.

4270-300', heavy mud.
300-225', wood plug, hulls, 25 sacks cement.
225-40', heavy mud.
40' to base of cellar, wood plug, hulls, 10 sacks cement.

RECEIVED
STATE CORPORATION COMMISSION

JAN 11 1965

CONSERVATION DIVISION
Wichita, Kansas

1-11-65

(If additional description is necessary, use BACK of this sheet)

Name of Plugging Contractor Gabbert-Jones, Inc.
Address Orpheum Bldg., Wichita, Kansas

STATE OF Kansas, COUNTY OF Barton, ss.
W. J. Devaney (employee of owner) of the above-described well, being first duly sworn on oath, says: That I have knowledge of the facts, statements, and matters herein contained and the log of the above-described well as filed and that the same are true and correct. So help me God.

(Signature) [Signature]
Box 308, Great Bend, Kansas
(Address)

SUBSCRIBED AND SWORN TO before me this 17th day of December, 19 64

My commission expires December 6, 1966

Notary Public.



R

WELL RECORD

WILDCAT
 DISCOVERY
 POOL

Company Cities Service Oil Company Well No. 1 Farm Richardson "A"
 Location 625' S. & 1945' W. of NE Corner Sec. 19 T. 30S R. 8W
 Elev. Serv. K.B. 1537' D.F. 1534' Gr. 1532' Co. Kingman State Kansas
 N. I. P. P. & A. 12/15/64 A. I. P. Grav.
 Pay Zones
 Perforations
 Acid Hydrafrac
 T. D. 4270' P. B. T. D. N. T. D. Drlg. Comm. 12/1/64 Drlg. Comm. 12/14/64

CASING RECORD

8 5/8" @ 411' w/300 sacks.

Formation Record:

	<u>Depth:</u>
sand & gravel	0 - 45
red rock	411
red beds	470
shale & shells	1280
shale	1400
shale & lime	1585
lime & shale	1750
lime	1810
lime & shale	2035
shale & lime	2320
sand	2332
shale & lime	2547
lime & shale	2675
shale & lime	2771
lime	3145
lime & shale	3320
lime & sand	3430
lime	4105
lime & shale	4210
Mississippian	4214
lime	4236
lime	4270 T.D.

Contractor Gabbert & Jones

Elec. log tops:

Indian Cave Sd.	2298'
Burlingame	2660'
Howard	2756'
Topeka	2868'
Heebner	3262'
Douglas	3304'
Lansing	3469'
Eros. Miss.	4191'
Miss. Chert	4210'
Miss. Ls.	4236'
Log T.D.	4273'

Slope Tests: Totco

1° @ 411'
3/4° @ 950'
1° @ 1585'
1° @ 1890'
1 1/2° @ 2332'
1 1/2° @ 2547'
1 1/2° @ 2890'
2° @ 3300'
3° @ 3620'
3 1/2° @ 3795'
3° @ 3955'
3° @ 4082'

RECEIVED
 STATE CORPORATION COMMISSION

JAN 11 1965

1-11-65
 CONSERVATION DIVISION
 Wichita, Kansas

Plugging Record

Heavy mud 300' - 4270'.
 Wood plug & hulls @ 300'.
 25 sacks cem. 225' - 300'.
 Heavy mud 40' - 225'.
 Wood plug & hulls @ 40'.
 10 sacks cem. callar to 40', 2 sacks cem. in rat hole.

1/6/65
 ng