

WELL PLUGGING RECORD

Give All Information Completely
Make Required Affidavit
Mail or Deliver Report to:
Conservation Division
State Corporation Commission
211 No. Broadway
Wichita, Kansas

Kingman County. Sec. 17 Twp. 30 Rge. 8 (X) W(W)

Location as "NE/CNW%SW%" or footage from lines NE NE NE

Lease Owner Petroleum, Inc.

Lease Name Osborn "B" Well No. 1

Office Address Route 2, Great Bend, Kansas

Character of Well (completed as Oil, Gas or Dry Hole) Oil

Date well completed March 29 1958

Application for plugging filed Sept. 18 1958

Application for plugging approved Sept. 19 1958


Plugging commenced October 10 1958

Plugging completed October 14 1958

Reason for abandonment of well or producing formation Depletion of producible zones

If a producing well is abandoned, date of last production July 24 1958

Was permission obtained from the Conservation Division or its agents before plugging was commenced? Yes

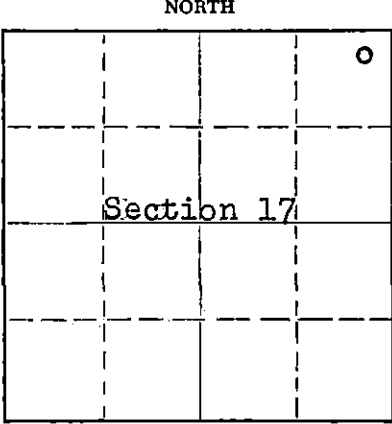

Locate well correctly on above Section Plat

Name of Conservation Agent who supervised plugging of this well Fred Hampel

Producing formation Mississippi Depth to top 4157' Bottom _____ Total Depth of Well 4214' Feet

Show depth and thickness of all water, oil and gas formations.

OIL, GAS OR WATER RECORDS

CASING RECORD

FORMATION	CONTENT	FROM	TO	SIZE	PUT IN	PULLED OUT
				8 5/8"	301'	none
Mississippi	Water, little oil & little gas	4159'	4173'	4 1/2"	4252'	3550'

Describe in detail the manner in which the well was plugged, indicating where the mud fluid was placed and the method or methods used in introducing it into the hole. If cement or other plugs were used, state the character of same and depth placed, from _____ feet to _____ feet for each plug set.

Filled hole with crushed rock from 4214' to 4050' followed by 5 sacks cement. Circulated 50 sacks gel at 1200'. Mud up to 250' and build solid rock bridge. Placed 20 sacks cement on top of bridge. Mud up to 35' and build solid rock bridge. Filled hole to base of well cellar with 10 sacks cement.

RECEIVED
STATE CORPORATION COMMISSION
OCT 18 1958
10-18-58
CONSERVATION DIVISION
Wichita, Kansas

(If additional description is necessary, use BACK of this sheet)

Name of Plugging Contractor Morgan Well Plugging Service

Address 102 West 18th Street, Hutchinson, Kansas

STATE OF Kansas, COUNTY OF Barton, ss.

Don Searle (employee of owner) or (owner/operator) of the above-described well, being first duly sworn on oath, says: That I have knowledge of the facts, statements, and matters herein contained and the log of the above-described well as filed and that the same are true and correct. So help me God.

(Signature) Don Searle

Route 2, Great Bend, Kansas

(Address)

SUBSCRIBED AND SWORN TO before me this 16th day of October, 1958

[Signature]
Notary Public.

My commission expires July 11, 1960

PLUGGING
FILE SEC. 17 T. 30 R. 8 W
BOOK PAGE 130 LINE 30

WELL LOG 15-095-01801-0000

COMPANY PETROLEUM, INCORPORATED

SEC. 17 T. 30S. 8W

FARM OSBORNE "B" NO. 1


LOC. NE, NE, NE

TOTAL DEPTH 4255'

COUNTY KINGMAN CO., KANSAS

COMM. February 27, 1958 COMP. March 11, 1958

CONTRACTOR GARVEE DRILLING COMPANY

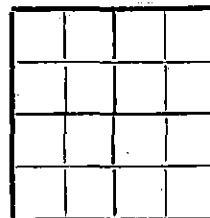

CASING 8 5/8" @ 301' W/225 sax
4 1/2" @ 4252' W/125 sax.

ELEVATION 1516' DF

PRODUCTION MISSISSIPPIAN

FIGURES INDICATE BOTTOM OF FORMATIONS

30	Surface soil
240	Red bed & shale
301	Red bed
406	Shale & shells
1792	Lime & shale
1942	Lime
2765	Shale
3080	Shale & lime
3429	Shale, sand & lime
3829	Lime
4084	Shale & lime
4175	Shale, lime & chert
4205	Chert
4215	Chert & lime
4255	Lime
4255	T. D.

RECEIVED
STATE CORPORATION COMMISSION
OCT 18 1958
CONSERVATION DIVISION
Wichita, Kansas

PLUGGING

FILE SEC. 17 T. 30 R. 8W

BOOK PAGE 130 LINE 30

State of KANSAS }
County of BARTON } ss:

I, VERNE A. MORRIS of GARVEE DRILLING COMPANY

upon oath state that the above and foregoing is a true and correct copy of the log of the #1 OSBORNE "B" well

Verne A. Morris

Subscribed and sworn to before me this 17th day of April 19 58

My Commission Expires: July 11, 1960

Jed J. Bishop
NOTARY PUBLIC