


Give All Information Completely
Make Required Affidavit
Mail or Deliver Report to:
Conservation Division
State Corporation Commission
211 No. Broadway
Wichita, Kansas

WELL PLUGGING RECORD

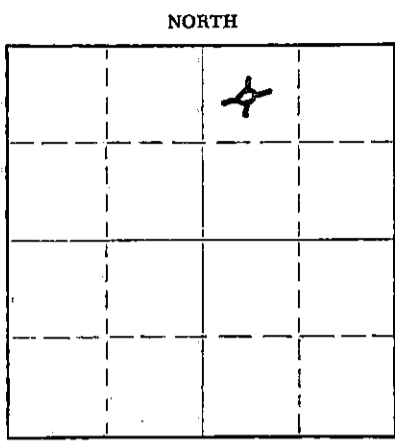

Kingman County, Sec. 21 Twp. 30S Rge. 8 (W)

Location as "NE/CNW/SW" or footage from lines. Ctr. NW NE

Lease Owner Champlin Petroleum Company

Lease Name Tjaden Well No. 1

Office Address P. O. Box 308, Ellinwood, Kansas

Character of Well (completed as Oil, Gas or Dry Hole) Gas

Date well completed October 4 19 67

Application for plugging filed November 30 19 67

Application for plugging approved December 1 19 67

Plugging commenced December 26 19 67

Plugging completed December 30 19 67

Reason for abandonment of well or producing formation Uneconomical Production.

If a producing well is abandoned, date of last production December 14 19 67

Was permission obtained from the Conservation Division or its agents before plugging was commenced? yes

Name of Conservation Agent who supervised plugging of this well A. Elving
Producing formation _____ Depth to top _____ Bottom _____ Total Depth of Well 4318 Feet

Show depth and thickness of all water, oil and gas formations.

OIL, GAS OR WATER RECORDS

CASING RECORD

FORMATION	CONTENT	FROM	TO	SIZE	PUT IN	PULLED OUT
				8 5/8" OD	269'	None
				5 1/2" OD	4318'	3423'

Describe in detail the manner in which the well was plugged, indicating where the mud fluid was placed and the method or methods used in introducing it into the hole. If cement or other plugs were used, state the character of same and depth placed, from _____ feet to _____ feet for each plug set.

Set wooden bridge at 300', dumped 10' of broken concrete on top of bridge, mud up to 260' then 10' of broken concrete and 25 sacks of cement then mud to 40' then 10' of broken concrete and 10 sacks of cement to fill hole to surface.

JAN 5 1968

Handwritten: 2 seal, 1-5-68

(If additional description is necessary, use BACK of this sheet)

Name of Plugging Contractor Clarke Corporation
Address Medicine Lodge, Kansas

STATE OF Kansas, COUNTY OF Barton, ss. J. W. Meyers (employee of owner) or (owner's representative) of the above-described well, being first duly sworn on oath, says: That I have knowledge of the facts, statements, and matters herein contained and the log of the above-described well as filed and that the same are true and correct. So help me God.

(Signature) *J. W. Meyers*
J. W. Meyers, Dist. Opt's. Mgr.
P. O. Box 308, Ellinwood, Kansas
(Address)

SUBSCRIBED AND SWORN TO before me this 3rd day of January 19 68

My commission expires 5/22/70
N. Kenneth Stivers
N. Kenneth Stivers Notary Public.

KANSAS GEOLOGICAL SOCIETY
KANSAS WELL LOG BUREAU - KANSAS WELL SAMPLING BUREAU
KANSAS GEOLOGICAL SOCIETY BUILDING
508 EAST MURDOCK - WICHITA, KANSAS

Champlin Oil & Refining Co.

COMPANY

Joe Tjaden

1

FARM

NO.

SEC. 21 30 R. 8
LOC. NW NE 1/4

COUNTY Kingman
KANSAS

TOTAL DEPTH 4318'
9/8/57
COMM. DATE
COMP. DATE 9/25/57

SHOT OR TREATED Armer, Inc.
CONTRACTOR
ISSUED

CASING

20	10	272'
15	8	
12	6	4318'
13	5	

ELEVATION 1587 K.B.
1584 D.F.

PRODUCTION

FIGURES INDICATE BOTTOM OF FORMATIONS

Red Bed & Sand	90'
Red Bed & Shale	530'
Shale & Gyp.	695'
Shale & Salt	975'
Shale & Shells	1415'
Shale & Lime	2045'
Shale & Shells	2455'
Shale & Lime	3155'
Lime	3285'
Shale & Lime	3495'
Lime	3788'
Shale & Lime	3910'
Lime	3982'
Lime & Shale	4018'
Shale	4065'
Shale & Lime	4235'
Chert	4268'
Chert & Lime	4305'
Lime & Shale	4318'

FORMATION TOPS:

Hoebner	3258'
Toronto	3271'
Douglas	3290'
Lansing	3476'
Marmaton	4035'
Cherokee	4180'
Mississippi Chat	4226'
Mississippi Lime	4293'

I hereby certify that this is a true and correct log of the above described well as shown by the drilling reports.

ARMER INC.



By L. C. Sponenberg
L. C. Sponenberg

OCT 4 1957

STATE OF KANSAS)
) SS
COUNTY OF SEDGWICK)

Subscribed and sworn to before me, a notary public, in and for said County and State this 1st day of October, 1957.

Rose Fussey
Notary Public

My Commission expires February 15, 1960.
STATE CORPORATION COMMISSION

DEC 1 1967

12-1-67

CONSERVATION DIVISION
Wichita, Kansas

DUPLICATE INVOICE

XERO COPY

XERO COPY

XERO COPY

XERO COPY