


STATE OF KANSAS  
STATE CORPORATION COMMISSION

WELL PLUGGING RECORD

Give All Information Completely  
Make Required Affidavit  
Mail or Deliver Report to  
Conservation Division  
State Corporation Comm.  
245 North Water  
Wichita, KS 67202

Kingman County. Sec. 21 Twp. 30 S Rge. 8 W E/W  
Location as "NE/CNW 1/4 SW 1/4" or footage from lines  
1780 FNL 1980 FEL  
Lease Owner Texas Oil and Gas Corporation  
Lease Name Messenger B Well No. 1  
Office Address Suite 300 - 200 W. Doulgas

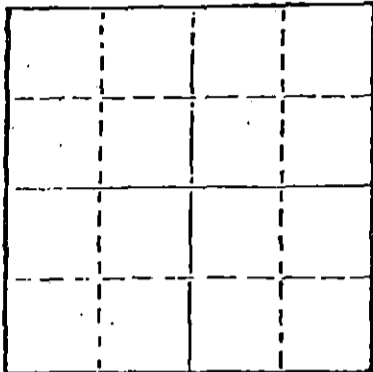

Locate well correctly on above  
Section Plot

Character of Well (Completed as Oil, Gas or Dry Hole) Gas  
Date Well completed 12-31 19 79  
Application for plugging filed 10-22 19 81  
Application for plugging approved 10-25 19 81  
Plugging commenced 1-21 19 82  
Plugging completed 2-1- 19 82  
Reason for abandonment of well or producing formation

If a producing well is abandoned, date of last production 19

Was permission obtained from the Conservation Division or its agents before plugging was commenced?

Name of Conservation Agent who supervised plugging of this well  
Producing formation Depth to top Bottom Total Depth of Well 4,238  
Show depth and thickness of all water, oil and gas formations.

OIL, GAS OR WATER RECORDS

CASING RECORD

FORMATION	CONTENT	FROM	TO	SIZE	PUT IN	PULLED OUT
				8 5/8	275	None
				4 1/2	4,823	3,542

Describe in detail the manner in which the well was plugged, indicating where the mud fluid was placed and the method or methods used in introducing it into the hold. If cement or other plugs were used, state the character of same and depth placed, from feet to feet for each plug set.

Plug back at 4,269  
Sand from 4,269 to 4,200  
4 sacks cement from 4,200 to 4,160  
Ripped 3,800 - 3,700  
Pumped in 15 jell - 6 hull - 10 jell  
150 sacks common cement - 3% C. C.

RECEIVED  
STATE CORPORATION COMMISSION

FEB - 5 1982

CONSERVATION DIVISION  
Wichita, Kansas

2-5-82

(If additional description is necessary, use BACK of this sheet)

Name of Plugging Contractor Clarke corporation

STATE OF Kansas COUNTY OF Barber, ss.  
Elmer K. Morgenstern (employee of owner) or (owner or operator)  
of the above-described well, being first duly sworn on oath, says: That I have knowledge of the facts, statements, and matters herein contained and the log of the above-described well as filed and that the same are true and correct. So help me God.

(Signature) Elmer K. Morgenstern  
Medicine Lodge, Kansas  
(Address)

SUBSCRIBED AND SWORN TO before me this 3rd day of February, 1982

Jessie Hamilton  
Notary Public.

My commission expires April 4, 1982.

DRILLERS LOG

15-095-20910-0000

OPERATOR: Texas Oil & Gas Corp.  
 200 West Douglas  
 Wichita, Kansas 67202

LEASE: Messenger 'B' #1  
 C SW NE Sec. 21-30S-8W  
 Kingman County, Kansas

CONTRACTOR: Slawson Drilling Company, Inc.  
 200 Douglas Building  
 Wichita, Kansas 67202

COMMENCED: 12/19/79

COMPLETED: 12/31/79

RTD: 4283'

SURFACE CASING: 8-5/8" set at 275' with 250 sx

PRODUCTION CASING: 4-1/2" set at 4283' with 150 sx

0' to 52' 16" pipe  
 52' to 279' Red Bed & Rock  
 279' to 1246' Shale  
 1246' to 1720' Shale  
 1720' to 1955' Shale & Lime  
 1955' to 3210' Shale  
 3210' to 3485' Shale, Lime & Sand  
 3485' to 3630' Lime & Shale  
 3630' to 3745' Lime  
 3745' to 3875' Shale  
 3875' to 3978' Shale & Lime  
 3978' to 3991' Shale  
 3991' to 4060' Shale & Lime  
 4060' to 4250' Lime  
 4250' to 4283' Mississippian  
 RTD 4283'

10-26-81

RECEIVED  
 STATE CORPORATION COMMISSIONER  
 OCT 20 1981  
 CONSERVATION DIVISION  
 Wichita, Kansas

STATE OF KANSAS  
 COUNTY OF SEDGWICK

I, James C. Remsberg, of the Slawson Drilling Company, Inc.  
 hereby state the above is an accurate copy of the Messenger 'B' log  
 for Texas Oil & Gas Corp.

*James C. Remsberg*  
 James C. Remsberg

Subscribed and sworn to me this  
 21st day of January, 1980

*Mary Lou Taylor*  
 Mary Lou Taylor, Notary

My commission expires January 17, 1981

