


Give All Information Completely
Make Required Affidavit
Mail or Deliver Report to:
Conservation Division
State Corporation Commission
P. O. Box 17027
Wichita, Kansas 67217
NORTH

WELL PLUGGING RECORD

Location as "NE/CNWxSWx" or footage from lines Hamilton County, Sec. 33 Twp. 24S, Rge. (E) 41 (W) _____
Lease Owner Antares Oil Corp.
Lease Name Gregory - Tate Well No. 2
Office Address 924 Patterson Bldg. Denver, Colo. 80202
Character of Well (completed as Oil, Gas or Dry Hole) _____
Date well completed _____ 19 _____
Application for plugging filed 10-15 19 73
Application for plugging approved _____ 19 _____
Plugging commenced 11-8 19 73
Plugging completed 11-9 19 73
Reason for abandonment of well or producing formation _____
If a producing well is abandoned, date of last production _____ 19 _____
Was permission obtained from the Conservation Division or its agents before plugging was commenced? Yes

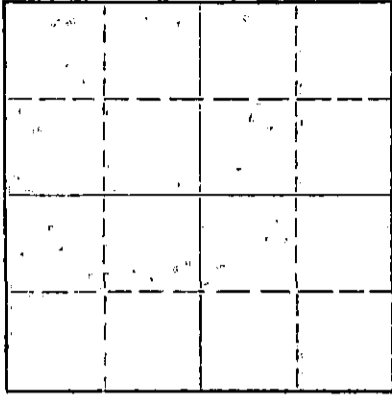

Locate well correctly on above Section Plat

Name of Conservation Agent who supervised plugging of this well Ed Eyes
Producing formation _____ Depth to top _____ Bottom _____ Total Depth of Well 2409 KB Feet
Show depth and thickness of all water, oil and gas formations.

OIL, GAS OR WATER RECORDS

CASING RECORD

FORMATION	CONTENT	FROM	TO	SIZE	PUT IN	PULLED OUT
				8 5/8	374	none
				4 1/2	2419	1540

Describe in detail the manner in which the well was plugged, indicating where the mud fluid was placed and the method or methods used in introducing it into the hole. If cement or other plugs were used, state the character of same and depth placed, from _____ feet to _____ feet for each plug set.


15 sks. of cement @ 2250 to 2390
35 sks. of cement @ 374 to 274
10 sks. of cement @ 40 to 0

RECEIVED
STATE CORPORATION COMMISSION
NOV 19 1973
CONSERVATION DIVISION
Wichita, Kansas

(If additional description is necessary, use BACK of this sheet)
Name of Plugging Contractor Sargents Casing Pulling Service Kansas No. 511
Address Box 506 Liberal, Kansas 67901

STATE OF Kansas, COUNTY OF Seward, ss. _____ (employee of owner) or (owner or operator), of the above-described well, being first duly sworn on oath, says: That I have knowledge of the facts, statements, and matters herein contained and the log of the above-described well as filed and that the same are true and correct. So help me God.

(Signature) Robert Sargent
Box 506 Liberal Kansas 67901
(Address)

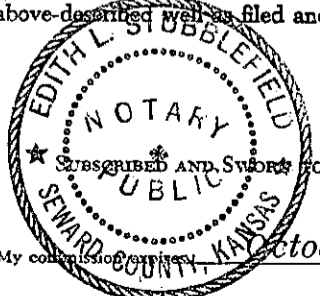

Subscribed and sworn to before me this 13th day of November, 19 73
Edith L. Stubblefield
Notary Public.

My commission expires October 5, 1975

ANTARES OIL CORPORATION

Gregory Tate No. 2 Well
Hamilton County, Kansas

OPERATIONS COMMENCED: 3-10-73

OPERATIONS COMPLETED: 3-13-73

DRILLERS LOG

3-10-73	0	104	Sand
	104	366	Sand & Blue Shale
3-11-73	366	410	Sand & Clay
	410	1131	Sand & Shale
	1131	1631	Sand & Shale
3-12-73	1631	2325	Shale & Anhy.
3-13-73	2325	2421	Shale & Anhy.

CASING RECORD

3-10-73 Ran 9 Jts. of used 8-5/8" casing. Set at 366'. Cement with 225 sacks of Class H, with 3% CC

3-13-73 57 Jts. of 9.5# 4½" used casing, cemented with 200 sacks of common.

RECEIVED
STATE CORPORATION COMMISSION
NOV 6 1973
CONSERVATION DIVISION
Wichita, Kansas