


STATE OF KANSAS  
STATE CORPORATION COMMISSION

WELL PLUGGING RECORD

Give All Information Completely  
Make Required Affidavit  
Mail or Deliver Report to:  
Conservation Division  
State Corporation Commission  
211 No. Broadway  
Wichita, Kansas

Stafford County. Sec. 30 Twp. 24 Rge. (E) 14 (W)  
Location as "NE/CNW/SW" or footage from lines SW SW SW  
Lease Owner Sunray Mid-Continent Oil Company  
Lease Name Hyler Well No. 1  
Office Address 321 West Douglas, Wichita 2, Kansas  
Character of Well (completed as Oil, Gas or Dry Hole) Oil  
Date well completed August 19, 19 57  
Application for plugging filed February 23, 19 62  
Application for plugging approved February 26, 19 62  
Plugging commenced March 10, 19 62  
Plugging completed March 13, 19 62  
Reason for abandonment of well or producing formation Depleted

NORTH

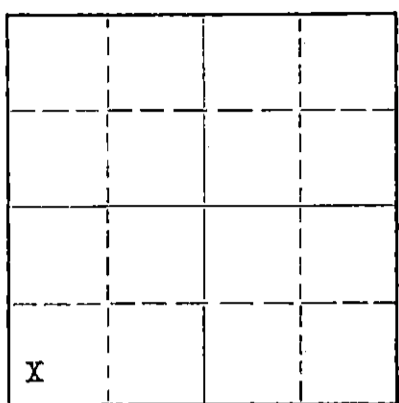

Locate well correctly on above  
Section Plat

If a producing well is abandoned, date of last production February 28, 19 62  
Was permission obtained from the Conservation Division or its agents before plugging was commenced? Yes

Name of Conservation Agent who supervised plugging of this well W. L. Lackamp  
Producing formation Arbuckle Lime Depth to top 4360' Bottom 4377' Total Depth of Well 4382' Feet  
Show depth and thickness of all water, oil and gas formations.

OIL, GAS OR WATER RECORDS

CASING RECORD

FORMATION	CONTENT	FROM	TO	SIZE	PUT IN	PULLED OUT
Arbuckle Lime	Oil	4360'	4377'	8 5/8"	302'	-0-
				5 1/2"	4351'	2301'

Describe in detail the manner in which the well was plugged, indicating where the mud fluid was placed and the method or methods used in introducing it into the hole. If cement or other plugs were used, state the character of same and depth placed, from \_\_\_\_\_ feet to \_\_\_\_\_ feet for each plug set.

Sanded from Total Depth to 4300'. Set Five (5) sacks cement at 4300'. Shot off pipe at 2310' and pulled. Mixed 15 sacks mud and pumped in hole. Filled with 80 sacks of cement to surface.

RECEIVED  
STATE CORPORATION COMMISSION

MAR 15 1962

CONSERVATION DIVISION  
Wichita, Kansas

3-15-62

(If additional description is necessary, use BACK of this sheet)

Name of Plugging Contractor Forbes Casing Pulling Company  
Address Great Bend, Kansas

STATE OF Kansas, COUNTY OF Sedgwick, ss.  
Gary W. Pierce (employee of owner) or (owner or operator) of the above-described well, being first duly sworn on oath, says: That I have knowledge of the facts, statements, and matters herein contained and the log of the above-described well as filed and that the same are true and correct. So help me God.

(Signature) Gary W. Pierce  
321 West Douglas, Wichita 2, Kansas  
(Address)

SUBSCRIBED AND SWORN TO before me this 14th day of March, 19 62

My commission expires July 13, 1963

W. M. Montgomery  
Notary Public.

