

STATE OF KANSAS  
STATE CORPORATION COMMISSION

Give All Information Completely  
Make Required Affidavit  
Mail or Deliver Report to:  
Conservation Division  
State Corporation Commission  
211 No. Broadway  
Wichita, Kansas

WELL PLUGGING RECORD

Stafford County, Sec. 30 Twp. 24 Rge. 14 (W)

Location as "NE/CNW/SW" or footage from lines NE NE NW  
Lease Owner WILKINSON DRILLING, INC & HOUSTON PETROLEUM CO.

Lease Name Dykes Well No. #1  
Office Address 805 Union Center Building, Wichita 2, Kansas.

Character of Well (completed as Oil, Gas or Dry Hole) Dry Hole  
Date well completed January 30, 1961

Application for plugging filed 1-30 1961

Application for plugging approved 1-30 1961


Plugging commenced 1-30 1961

Plugging completed 1-30 1961

Reason for abandonment of well or producing formation Dry Hole

If a producing well is abandoned, date of last production 19

Was permission obtained from the Conservation Division or its agents before plugging was commenced? Yes

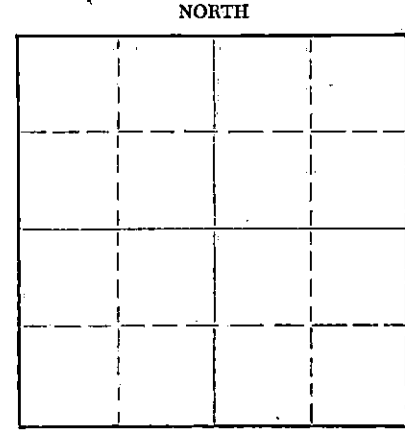

Locate well correctly on above Section Plat

Name of Conservation Agent who supervised plugging of this well Frank Broadfoot

Producing formation Depth to top Bottom Total Depth of Well 4453' Feet

Show depth and thickness of all water, oil and gas formations.

OIL, GAS OR WATER RECORDS

CASING RECORD

FORMATION	CONTENT	FROM	TO	SIZE	PUT IN	PULLED OUT
				8 5/8	2.80	

Describe in detail the manner in which the well was plugged, indicating where the mud fluid was placed and the method or methods used in introducing it into the hole. If cement or other plugs were used, state the character of same and depth placed, from feet to feet for each plug set.

Bottom Plug @240' W/1/4 sack Hulls and 20 sacks cement  
Top Plug @40' W/10 sacks cement, Completed @ 4:30 pm

2-17-61

RECEIVED  
STATE CORPORATION COMMISSION

FEB 17 1961

CONSERVATION DIVISION  
Wichita, Kansas

Name of Plugging Contractor WILKINSON DRILLING, INC.  
Address 805 Union Center Building, Wichita 2, Kansas.

STATE OF Kansas, COUNTY OF Sedgwick, ss.  
Walter M. Wilkinson (employee of owner) or (owner or operator)

well, being first duly sworn on oath, says: That I have knowledge of the facts, statements, and matters herein contained and the log of the above-described well as filed and that the same are true and correct. So help me God.

(Signature) Walter M. Wilkinson

805 Union Center Building, Wichita 2, Kan (Address)

SUBSCRIBED AND SWORN TO before me this 30th day of January, 1961

My commission expires January 2, 1965

Carolyn K. Moore Iverson Notary Public.



February 14, 1961

DYKES #1

Company: WILKINSON DRILLING, INC.  
 Contractor: Company Tools  
 Commenced: January 18, 1961  
 Completed: January 30, 1961  
 Total Depth: 4453'  
 Location: NE NE NW, Section 30-24-14,  
 Stafford County, Kansas.  
 Elevation: 2004' Kelly Bushing  
 Casing: 8 5/8" @280' W/235 sacks

FIGURES INDICATE BOTTOMS OF FORMATIONS

<u>DEPTH</u>	<u>FORMATION</u>
0 - 95	Surface soil and sand
95 - 281	Shale & Shells
281 - 450	Shale & Red Beds
450 - 955	Red Beds, Shale & Shells
955 - 980	ANHYDRITE
980 - 1445	Shale & Lime Streaks
1445 - 2030	Lime & Shale
2030 - 3592	Shale & Lime
3592 - 3600	HEEBNER Shale
3600 - 3630	Lime & Shale
3630 - 3736	Shale & Silty Shale
3736 - 4062	Lime & Shale Streaks
4062 - 4100	Shale
4100 - 4160	Chert & Shale
4160 - 4204	Shale
4204 - 4360	Chert & Shale Streaks
4360 - 4410	Shale
4410 - 4416	Sand
4416	ARBUCKLE DOLOMITE
ROTARY TOTAL DEPTH	4416'

**RECEIVED**  
 STATE CORPORATION COMMISSION

FEB 17 1961

CONSERVATION DIVISION  
 Wichita, Kansas

We hereby certify the above and foregoing to be a true and correct copy of the Log on the Dykes #1, located in the NE NE NE, Section 30-24-14, Stafford County, Kansas.

WILKINSON DRILLING, INC.

*Walter M. Verheusen*

Subscribed and sworn to before me this fourteenth day of February, nineteen hundred and sixty one.

*Carolyn K. Swanson*

My commission expires January 24, 1965