


STATE OF KANSAS  
STATE CORPORATION COMMISSION  
Give All Information Completely  
Make Required Affidavit  
Mail or Deliver Report to:  
Conservation Division  
State Corporation Commission  
212 North Market, Insurance Bldg.  
Wichita, Kansas

### WELL PLUGGING RECORD

Stafford County. Sec. 30 Twp. 24 Rge. 14 (E) W (W)  
Location as "NE/CNW%SW%" or footage from lines SW SW NE  
Lease Owner Ferguson Oil Company  
Lease Name Dykes Well No. 1  
Office Address 427 Union Center, Wichita 2, Kansas  
Character of Well (completed as Oil, Gas or Dry Hole) Dry Hole  
Date well completed October 24, 19 60  
Application for plugging filed 10-24 19 60  
Application for plugging approved 10-24 19 60  
Plugging commenced 10-24 19 60  
Plugging completed 10-24 19 60  
Reason for abandonment of well or producing formation Dry Hole

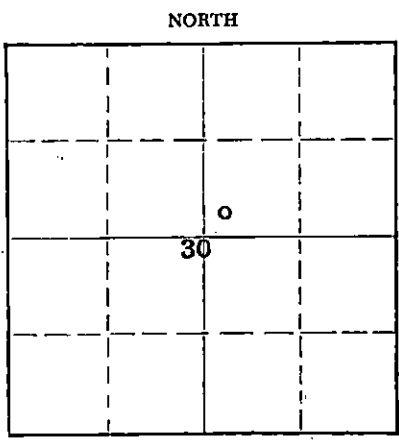

Locate well correctly on above Section Plat

If a producing well is abandoned, date of last production \_\_\_\_\_ 19 \_\_\_\_  
Was permission obtained from the Conservation Division or its agents before plugging was commenced? Yes

Name of Conservation Agent who supervised plugging of this well Frank Broadfoot  
Producing formation \_\_\_\_\_ Depth to top \_\_\_\_\_ Bottom \_\_\_\_\_ Total Depth of Well 4415 Feet  
Show depth and thickness of all water, oil and gas formations.

#### OIL, GAS OR WATER RECORDS

#### CASING RECORD

FORMATION	CONTENT	FRDM	TO	SIZE	PUT IN	PULLED OUT
		0	267	8-5/8"	267'	None

Describe in detail the manner in which the well was plugged, indicating where the mud fluid was placed and the method or methods used in introducing it into the hole. If cement or other plugs were used, state the character of same and depth placed, from \_\_\_\_\_ feet to \_\_\_\_\_ feet for each plug set.

Filled hole with mud to 225'  
Set bottom plug at 225' with 1/2 sack hulls and  
20 sacks cement through pipe. Set top plug at  
30' with 10 sacks cement, 1/2 sack hulls.

10-27-60  
RECEIVED  
STATE CORPORATION COMMISSION  
OCT 27 1960  
CONSERVATION DIVISION  
Wichita, Kansas

(If additional description is necessary, use BACK of this sheet)  
Name of Plugging Contractor Hellar Drilling Company, Inc.  
Address 1014 Union Center, Wichita 2, Kansas

STATE OF KANSAS, COUNTY OF SEDGWICK, ss.  
D. L. Hellar, Hellar Drilling Co. (employee of owner) or (owner or operator) of the above-described well, being first duly sworn on oath, says: That I have knowledge of the facts, statements, and matters herein contained and the log of the above-described well as filed and that the same are true and correct. So help me God.

(Signature) [Signature]  
1014 Union Center  
(Address)

SUBSCRIBED AND SWORN TO before me this 26th day of October, 19 60

My commission expires March 6, 1961. Manda Lou Buer Notary Public.



CONTRACTOR'S WELL LOG

OWNER:  
CONTRACTOR:  
LEASE:  
LOCATION:  
  
COMMENCED:  
COMPLETED:  
CASING:

Ferguson Oil Company  
Hellar Drilling Company, Inc.  
Dykes #1  
SW SW NE, Sec. 30-24S-14W  
Stafford County, Kansas  
October 12, 1960  
October 24, 1960  
Set 8-5/8" surface casing  
@ 267' w/220 sacks cement

		Elevation	2000 KB
0 - 273	Clay, sand, shale		
273 - 925	Red bed, sand, shale		
925 - 954	Red bed		
954 - 985	Anhydrite	954	-1046
985 - 1665	Shale, shells	Heebner	3594 -1594
1665 - 2000	Shale, lime	Douglas	3611 -1611
2000 - 2335	Lime, shale	Brown Lime	3717 -1717
2335 - 2978	Shale, lime	Lansing	3737 -1737
2978 - 3341	Lime, shale	Mississippi	4110 -2110
3341 - 3540	Lime	Viola	4203 -2203
3540 - 3610	Lime, shale	Simpson Shale	4326 -2326
3610 - 3965	Lime	Arbuckle	4376 -2376
3965 - 4035	Lime, shale		
4035 - 4143	Lime		
4143 - 4157	Cherty shale		
4157 - 4190	Mississippian chert & lime		
4190 - 4230	Mississippian lime		
4230 - 4265	Lime		
4265 - 4305	Viola lime		
4305 - 4330	Cherty lime		
4330 - 4415	Lime, Arbuckle		
4415	Rotary Total Depth		
	D & A		

RECEIVED  
STATE COMMISSION  
OCT 27 1960  
CONSERVATION DIVISION  
Wichita, Kansas

STATE OF KANSAS )  
                          ) SS:  
COUNTY OF SEDGWICK)

I, D. L. Hellar, do hereby certify that the above and foregoing is a true and correct copy of the log of the DYKES #1, SW SW NE, Section 30-24S-14W, Stafford County, Kansas, as reflected by the files of the Hellar Drilling Company, Inc.

HELLAR DRILLING COMPANY, INC.

BY D.L. Hellar  
D.L. Hellar, President

Subscribed and sworn to before me, a Notary Public, in and for Sedgwick County, Kansas, this 26th day of October, 1960.

Nanda Lou Bruce  
Notary Public

My commission expires March 6, 1961.