

CONFIDENTIAL

CONFIDENTIAL

COPY

SIDE ONE


STATE CORPORATION COMMISSION OF KANSAS
OIL & GAS CONSERVATION DIVISION
WELL COMPLETION FORM
ACO-1 WELL HISTORY
DESCRIPTION OF WELL AND LEASE

Operator: License # 04680
Name: American Exploration Co.
Address 2100 NCNB Center
700 Louisiana
City/State/Zip Houston, Texas 77002
Purchaser: KN Energy
Operator Contact Person: Marty R. McClanahan
Phone (713) 220-8251
Contractor: Name: Cheyenne Drilling Co.
License: 5382
Wellsite Geologist: Gary Oliver

Designate Type of Completion
 New Well Re-Entry Workover
 Oil SWD Temp. Abd.
 Gas Inj Delayed Comp.
 Dry Other (Core, Water Supply, etc.)

If OWMO: old well info as follows:
Operator: _____
Well Name: _____
Comp. Date _____ Old Total Depth _____
Drilling Method:
 Mud Rotary Air Rotary Cable
5/25/90 5/28/90 6/24/90
Spud Date Date Reached TD Completion Date

API NO. 15- 075-20,438-0000
County Hamilton
SE/4 Sec. 15 Twp. 24S Rge. 41 East West
1320 Ft. North from Southeast Corner of Section
1320 Ft. West from Southeast Corner of Section
(NOTE: Locate well in section plat below.)
Lease Name HCU Well # 1541-B
Field Name Bradshaw
Producing Formation Winfield
Elevation: Ground 3271 KB _____
Total Depth 2446 PBDT 2410

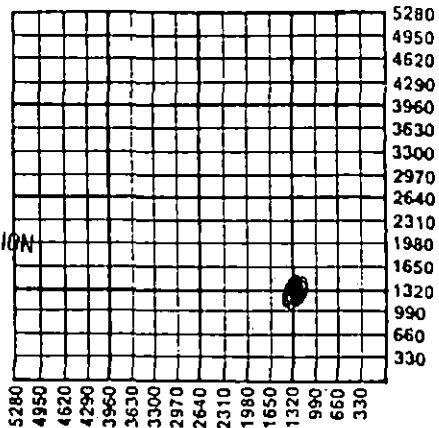

8-22-90

Amount of Surface Pipe Set and Cemented at 357 Feet
Multiple Stage Cementing Collar Used? Yes No
If yes, show depth set _____ Feet
If Alternate II completion, cement circulated from 357-2446
feet depth to Surface w/ 170 850 sx cmt.

INSTRUCTIONS: This form shall be completed in triplicate and filed with the Kansas Corporation Commission, 200 Colorado Derby Building, Wichita, Kansas 67202, within 120 days of the spud date of any well. Rule 82-3-130, 82-3-107 and 82-3-106 apply. Information on side two of this form will be held confidential for a period of 12 months if requested in writing and submitted with the form. See rule 82-3-107 for confidentiality in excess of 12 months. One copy of all wireline logs and drillers time log shall be attached with this form. ALL CEMENTING TICKETS MUST BE ATTACHED. Submit CP-4 form with all plugged wells. Submit CP-111 form with all temporarily abandoned wells. Any recompletion, workover or conversion of a well requires filing of ACO-2 within 120 days from commencement date of such work.

All requirements of the statutes, rules and regulations promulgated to regulate the oil and gas industry have been fully complied with and the statements herein are complete and correct to the best of my knowledge.

Signature Marty R. McClanahan
Title Production Analyst Date 8/09/90
Subscribed and sworn to before me this 9 day of August,
19 90
Notary Public, State and for Harris County, Texas
Date Commission Expires AUG. 25, 1990

K.C.C. OFFICE USE ONLY
F Letter of Confidentiality Attached
C Wireline Log Received
C Drillers Timelog Received
Distribution
 KCC SWD/Rep NGPA
 KGS Plug Other
Oil Gas Pro
(Specify)

DRILLERS LOG

AMERICAN EXPLORATION COMPANY
HCU #1541-B
SECTION 15-T24S-R41W
HAMILTON COUNTY, KANSAS

COMMENCED: 05-25-90
COMPLETED: 05-28-90

SURFACE CASING: 340' OF 8 5/8"
CMTD W/130 SX DSLW, 6% GEL,
3% C.C., 1/4#/SX D-29; TAILED
IN W/100 SX "H", 3% C.C., 1/4#/SX D-29

FORMATION	DEPTH
SURFACE HOLE	0- 355
SAND & CLAY	355-1675
SHALE	1675-1804
CLAY & SHALE	1804-2446 RTD

I DO HEREBY CERTIFY THAT THE FOREGOING STATEMENTS ARE TRUE AND CORRECT TO THE BEST OF MY KNOWLEDGE AND BELIEF.


CHEYENNE DRILLING, INC.

A.J. JACQUES

STATE OF KANSAS :ss:

SUBSCRIBED AND SWORN TO BEFORE ME THIS 30TH DAY OF MAY, 1990.

BECKY J. WHETSTONE, NOTARY PUBLIC

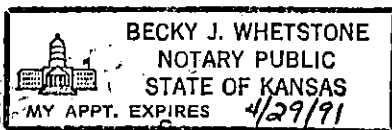

STATE CO

01 1990
CONSERVATION DIVISION
Wichita, Kansas