


WELL PLUGGING RECORD
OR
FORMATION PLUGGING RECORD

15-009-19246-0000

Strike out upper line when reporting plugging of formations.

Give All Information Completely
Make Required Affidavit
Mail or Deliver Report to:
Conservation Division
State Corporation Commission
800 Bittling Building
Wichita, Kansas

NORTH

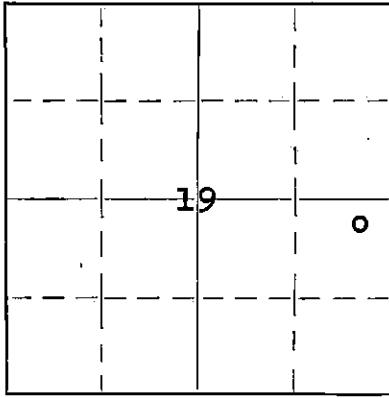

Locate well correctly on above Section Plat

BARTON County. Sec 19 Twp 16 Rge. (E) 11 (W)
Location as "NE $\frac{1}{4}$ NW $\frac{1}{4}$ SW $\frac{1}{4}$ " or footage from lines NE NE SE; 440' NL; 440' EL
Lease Owner SHELL OIL CO., INC.
Lease Name A. E. REDETZKE Well No. 1
Office Address BOX 744, GREAT BEND, KANSAS
Character of Well (Completed as Oil, Gas or Dry Hole) DRY HOLE
Date, well completed SEPTEMBER 27, 1940 193
Application for plugging filed SEPTEMBER 30, " 193
Application for plugging approved OCTOBER 1 " 193
Plugging Commenced OCTOBER 11 " 193
Plugging Completed OCTOBER 18 " 193
Reason for abandonment of well or producing formation DRY HOLE

If a producing well is abandoned, date of last production 193
Was permission obtained from the Conservation Division or its agents before plugging was commenced? YES

Name of Conservation Agent who supervised plugging of this well C. T. ALEXANDER
Producing formation ARBUCKLE DOLOMITE Depth to top 3359 Bottom Total Depth of Well 3364 Feet.
Show depth and thickness of all water, oil and gas formations.

OIL, GAS OR WATER RECORDS

CASING RECORD

| Formation | Content | From | To | Size | Put In | Pulled Out |
|-------------------|-------------|------|------|--------|--------|------------|
| ARBUCKLE DOLOMITE | 2130' WATER | 3360 | 3364 | 8 5/8" | 344' | NONE |
| | | | | 4 1/2" | 3360' | 1774' |

Describe in detail the manner in which the well was plugged, indicating where the mud fluid was placed and the method or methods used in introducing it into the hole. If cement or other plugs were used, state the character of same and depth placed, from feet to feet for each plug set.

SET LANE-WELLS DRILLABLE BRIDGING PLUG AT 3342' AND COVERED WITH RIVER GRAVEL TO 3341'. FILLED WITH MUD AND CHAT FROM 3341' TO 2990' AND CAPPED WITH CEMENT FROM 2990' TO 2970'. FILLED WITH MUD FROM 2970' TO 344'; SET BRIDGE AND DUMPED 10 SACKS OF CEMENT. FILLED WITH MUD TO WITHIN 15' OF TOP AND CAPPED WITH CEMENT.

PLUGGING
FILE SEC. 19 T. 16 R. 11 W.
BOOK PAGE 18 LINE 4

(If additional description is necessary, use BACK of this sheet)

Correspondence regarding this well should be addressed to SHELL OIL CO., INC.
Address C/O W. M. GHOLSON, BOX 744, GREAT BEND, KANSAS

STATE OF KANSAS COUNTY OF BARTON, ss.
W. M. GHOLSON (employee of owner) ~~known to me~~ of the above-described well,

being first duly sworn on oath, says: That I have knowledge of the facts, statements, and matters herein contained and the log of the above-described well as filed and that the same are true and correct. So help me God.

(Signature) [Signature]

BOX 744, GREAT BEND, KANSAS
(Address)

SUBSCRIBED AND SWORN to before me this 22 day of OCTOBER

My commission expires 12-1-40

OCT 23 1940
STATE CORP. COM. DISTRICT
CO. SEEN. DIV.
Notary Public.
10-23-40

15-009-19246-000

SHELL, A. E. REDETZKE #1
NE NE SE 19-16S-11W,
BARTON COUNTY, KANSAS

CASING RECORD

8 5/8" cem. 344' with 100 sax.
4 1/2" cem. 3360' with 100 sax.

- 0 - 65 Clay, rock & sand
- 233 Sand, lime & pyrite
- 344 Red bed
- 445 Shale
- 470 Sand, shale & pyrite
- 610 Shale & pyrite
- 648 Red rock
- 740 Shale & pyrite
- 773 Shale & gyp
- 1194 Shale & shells
- 1400 Shale & salt
- 1529 Shale & anhydrite
- 1598 Lime & anhydrite
- 1646 Lime, shale & chert
- 1739 Shale & lime streaks
- 1820 Lime, shale, pyrite & chert
- 1884 Lime & chert streaks
- 1895 Lime & chert
- 1917 Shale
- 1994 Lime broken
- 2030 Lime & chert
- 2076 Broken lime & shale
- 2135 Lime broken
- 2415 Shale & lime
- 2484 Shale
- 2520 Shale & lime
- 2545 Lime & chert
- 2700 Shale & lime
- 2988 Lime TOP TOPEKA LIME 2698'
- 2994 Sand
- 3323 Lime TOP LANSING-KANSAS CITY 3053'
- 3359 Lime & sand
TOP ARBUCKLE DOLOMITE 3359'
- 3364 Dolomite T.D.

PLUGGING
 FILE SET 19-16-11W
 BOOK PAGE 118 LINE 4

John ...