


STATE OF KANSAS
STATE CORPORATION COMMISSION

Give All Information Completely
Make Required Affidavit
Mail or Deliver Report to:
Conservation Division
State Corporation Commission
800 Biting Building
Wichita, Kansas

15-167-00354-00-00
WELL PLUGGING RECORD

NORTH

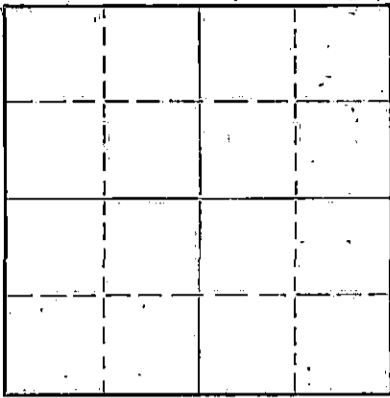

Locate well correctly on above
Section Flat

Russell County Sec. 26 Twp. 12 Rge. 15 (W)
Location as "NE/CNW/SW" or footage from lines SW SW SE
Lease Owner Anschutz Drilling Company, Inc.
Lease Name Ross Well No. 1
Office Address 612 Union National Bank Bldg., Wichita, Kans.
Character of Well (completed as Oil, Gas or Dry Hole) Dry hole
Date well completed 12-26 19 19
Application for plugging filed 12-26 19 19
Application for plugging approved 12-26 19 19
Plugging commenced 12-26 19 19
Plugging completed 12-26 19 19
Reason for abandonment of well or producing formation Dry

If a producing well is abandoned, date of last production 19
Was permission obtained from the Conservation Division or its agents before plugging was commenced? yes

Name of Conservation Agent who supervised plugging of this well C. D. Stough
Producing formation Depth to top Bottom Total Depth of Well 3315 Feet
Show depth and thickness of all water, oil and gas formations.

OIL, GAS OR WATER RECORDS

CASING RECORD

Formation	Content	From	To	Size	Put In	Pulled Out
				8-5/8"	134'	-

Describe in detail the manner in which the well was plugged, indicating where the mud fluid was placed and the method or methods used in introducing it into the hole. If cement or other plugs were used, state the character of same and depth placed, from feet to feet for each plug set.

Filled hole with heavy mud; set wood plug at 134';
cemented with 15 sacks bulk cement; set wood plug
20' below base of cellar, cemented with 10 sacks bulk cement.

(If additional description is necessary, use BACK of this sheet)

Correspondence regarding this well should be addressed to Anschutz Drilling Company, Inc.
Address 612 Union National Bank Building, Wichita, Kansas

STATE OF KANSAS COUNTY OF SEDGWICK ss.
H. R. Jensen (employee of owner) or (owner or operator) of the above-described well,
being first duly sworn on oath, says: That I have knowledge of the facts, statements, and matters herein contained and the log of the above-described well as filed and that the same are true and correct. So help me God.

(Signature) H. R. Jensen
612 Union National Bank Bldg., Wichita, Kans.
(Address)

SUBSCRIBED AND SWORN to before me this 30th day of December 19 19

RECEIVED
Conservation Division

Notary Public.

My commission expires September 12, 1953

22-5133-8 9-48-10M

DEC 31 1949 12-31-49

PLUGGING
FILE SEC 26 T 12 R 15 W
BOOK PAGE 13 LINE 43

WELL LOG

Anschutz Drilling Co., Inc., et al
Ross #1

NE NE/4 Sec. 26-12-15
Russell County, Kans.

Total Depth: 3315'
Comm: 12-14-49 Comp: 12-26-49
Contractor: J.D. Ferrell Drilling Co., Inc.
Issued 12-29-49; Rotary: 3315'

Elev:
Production: Dry

Casing Record: 134' New 8 5/8" 24# Surface Casing
cemented w/125 sc buld cement & 1 sk CC.

Figures Indicate Bottom of Formations:

cellar	4		
Post Rock	50		
Shale & shells	135		
Shells	320		
sand	370		
shale & Red bed	645	Tops:	
red bed & shells	860	Topeka	2672
Anhydrite	915	Hoebner	2939
Anhydrite & redbed	945	Dodge	2955
Red bed & shells	1110	Lansing K.C.	2984
shale & shells	1240	Total Depth	3315
salt & shells	1355		
salt	1420		
shale & lime	1590		
lime	1620		
lime & shale	2655		
shale	2673		
Broken lime	2726		
lime & shale	2770		
lime	3315		
Total Depth	3315		

We hereby certify this to be a true and accurate log of the above described well as shown by the daily drilling reports.

J.D. FERRELL DRILLING CO., INC.,

By: Vivian Bidder

Subscribed and sworn to before me this 29th day of December, 1949.

My Commission Expires:
10-15-51

Merle J. Sandys
Notary BPublic

