


Give All Information Completely
Make Required Affidavit
Mail or Deliver Report to:
Conservation Division
State Corporation Commission
800 Bittig Building
Wichita, Kansas

15.167.00287.00.00

WELL PLUGGING RECORD

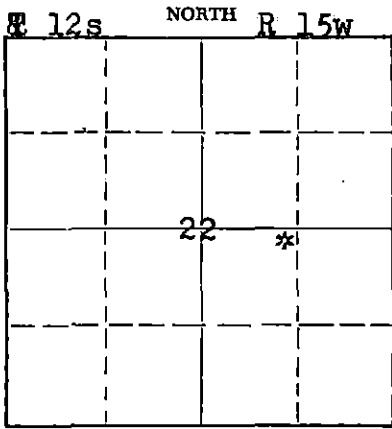

Locate well correctly on above Section Plat

Russell County. Sec. 22 Twp. 12S Rge. 15W (E) (W)
Location as "NE/CNW*SW*" or footage from lines NE NW SE
Lease Owner Petroleum Management, Inc.
Lease Name Steinert Well No. 1
Office Address 810 Central Building- Wichita, Kansas
Character of Well (completed as Oil, Gas or Dry Hole) Dry hole
Date well completed _____ 19____
Application for plugging filed November 15 1955
Application for plugging approved _____ 19____
Plugging commenced November 14 1955
Plugging completed November 21 1955
Reason for abandonment of well or producing formation _____

If a producing well is abandoned, date of last production _____ 19____
Was permission obtained from the Conservation Division or its agents before plugging was commenced? Yes

Name of Conservation Agent who supervised plugging of this well Milton Galyardt
Producing formation _____ Depth to top _____ Bottom _____ Total Depth of Well 3306 Feet
Show depth and thickness of all water, oil and gas formations.

OIL, GAS OR WATER RECORDS

CASING RECORD

FORMATION	CONTENT	FROM	TO	SIZE	PUT IN	PULLED OUT
				8-5/8"	205'	None
				5-1/2"	3272'	1983'
				Casing was perforated from 3007'.		

Describe in detail the manner in which the well was plugged, indicating where the mud fluid was placed and the method or methods used in introducing it into the hole. If cement or other plugs were used, state the character of same and depth placed, from _____ feet to _____ feet for each plug set.

Filled the hole with sand from 3306' to 2995' and ran 5 sacks of cement. Mudded the hole to 200', set a 10' rock bridge and ran 15 sacks of cement at 190'. Mudded the hole to 40', set a 10' rock bridge and ran 10 sacks of cement on top. Plugging completed.

12-23-55

(If additional description is necessary, use BACK of this sheet)
Name of Plugging Contractor West Supply Co., Inc.
Address Chase, Kansas

STATE OF Kansas, COUNTY OF Sedgewick, ss.
John F. Richey (employee of owner) or (owner or operator) of the above-described well, being first duly sworn on oath, says That I have knowledge of the facts, statements, and matters herein contained and the log of the above-described well as filed and that the same are true and correct. So help me God.

(Signature) John F. Richey
810 Central Bldg. Wichita Kans. (Address)

SUBSCRIBED AND SWORN TO before me this 29th day of November, 1955

My commission expires April 23, 1958
Maurice C. Murphy Notary Public.

PLUGGING
FAR SEC 22 T 12 R 15 W
BOOK PAGE 16 LINE 29.

WELL LOG BUREAU—KANSAS GEOLOGICAL SOCIETY
508 East Murdock, Wichita, Kansas


COPY

Company: FRED B. ANSCHUTZ
Farm: Steinert "A" No. 1

SEC. 22 T. 12 R. 15W
NE NW SE

Total Depth. 3306
Comm. 10-19-55 Comp. 10-27-55
Shot or Treated.
Contractor: Anschutz Drilling Co., Inc.
Issued: 1-28-56

County Russell
KANSAS

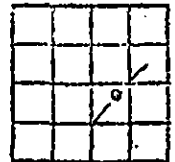

Elevation. 1822 DF

Production. Dry

CASING:

8 5/8 201' w/ 140 sx cmt.
5 1/2 3272' w/ 75 sx cmt.

Figures Indicate Bottom of Formations.

soil, post rock & sand	60
shale & shells	209
shale	310
sand	530
red bed	615
red bed & shale	887
anhydrite	925
shale, shells & salt	1435
lime & shale	1965
shale	2095
shale & lime	2355
shale	2550
shale & lime	3010
lime	3275
lime	3306
Total Depth	

RTD

TOPS:	
Stone Corral (anhydrite)	887
Topeka	2730
Heebner	2946
Toronto	2965
Lansing-K. C.	2996
Basal Penn. Conglomerate	none
Arbuckle	3271

RECEIVED
STATE CORPORATION COMMISSION
JUN 4 1970
CONSERVATION DIVISION
Wichita, Kansas