

STATE OF KANSAS  
STATE CORPORATION COMMISSION

Give All Information Completely  
Make Required Affidavit  
Mail or Deliver Report to:  
Conservation Division  
State Corporation Commission  
211 No. Broadway  
Wichita, Kansas


15. 162. 00139. 00. 00

WELL PLUGGING RECORD

Russell County, Sec. 22 Twp. 12S Rge. 15 (E) W (W)

Location as "NE/CNWxSWx" or footage from lines SW/4 SW/4 SW/4  
Lease Owner Birmingham-Bartlett Drilling Co.  
Lease Name Schneidler "A" Well No. 1  
Office Address 300 Kaufman Bldg., Wichita 2, Kansas  
Character of Well (completed as Oil, Gas or Dry Hole) Dry Hole  
Date well completed October 5, 19 56  
Application for plugging filed (Verbal) October 5, 19 56  
Application for plugging approved (Verbal) October 5, 19 56  
Plugging commenced October 5, 19 56  
Plugging completed October 5, 19 56  
Reason for abandonment of well or producing formation Dry Hole

NORTH

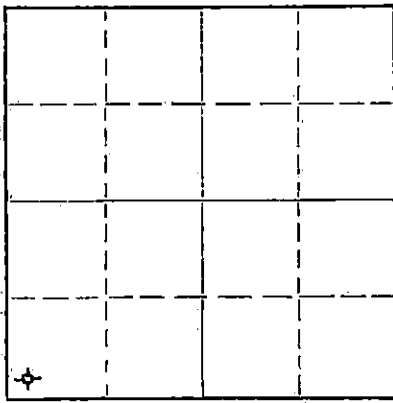

Locate well correctly on above  
Section Plat

If a producing well is abandoned, date of last production 19  
Was permission obtained from the Conservation Division or its agents before plugging was commenced? Yes

Name of Conservation Agent who supervised plugging of this well Milton Galyardt  
Producing formation \_\_\_\_\_ Depth to top \_\_\_\_\_ Bottom \_\_\_\_\_ Total Depth of Well 3320 Feet  
Show depth and thickness of all water, oil and gas formations.

OIL, GAS OR WATER RECORDS

CASING RECORD

FORMATION	CONTENT	FROM	TO	SIZE	PUT IN	PULLED OUT
		0	226'	8-5/8"	226'	none

Describe in detail the manner in which the well was plugged, indicating where the mud fluid was placed and the method or methods used in introducing it into the hole. If cement or other plugs were used, state the character of same and depth placed, from \_\_\_\_\_ feet to \_\_\_\_\_ feet for each plug set.

15 sacks cement, 1/2 sack hulls on bottom. Plug set at 220'.  
10 sacks cement, 1/2 sack hulls on top. Plug set at 40'.  
All cement mixed and poured through drill pipe. Filled with mud to surface.

(If additional description is necessary, use BACK of this sheet)

Name of Plugging Contractor Birmingham-Bartlett Drilling Co.  
Address 300 Kaufman Bldg., Wichita, Kansas

STATE OF KANSAS, COUNTY OF SEDGWICK  
Richard Hindery, Partner of Birmingham-Bartlett Drilling Co., ss. Owner, Operator, & Contractor  
(employee of owner) or (owner or operator) of the above-described well, being first duly sworn on oath, says: That I have knowledge of the facts, statements, and matters herein contained and the log of the above-described well as filed and that the same are true and correct. So help me God. BIRMINGHAM-BARTLETT DRILLING CO.

(Signature) By Richard Hindery Partner  
300 Kaufman Bldg., Wichita, Kansas  
(Address)

SUBSCRIBED AND SWORN to before me this 8th day of October, 19 56

My commission expires October 2, 1958.

Beverly Larson Notary Public.

PLUGGING  
FILE SEC. 22 T. 12 R. 15W  
BOOK PAGE 105 LINE 30

OCT 10 1956  
CONSERV. DIVISION  
WICHITA, KANSAS

10-10-56

