


15. 167. 00137. 00. 00

WELL PLUGGING RECORD

Give All Information Completely
Make Required Affidavit
Mail or Deliver Report to:
Conservation Division
State Corporation Commission
800 Bittling Building
Wichita, Kansas

Russell County. Sec. 22 Twp. 12S Rge. 15 (W)
Location as "NE/CNW/SW" or footage from lines NW NW SW
Lease Owner Anschutz Drilling Co., Inc.
Lease Name Schmeidler Well No. 1
Office Address 1 1/2 Mile High Center
Character of Well (completed as Oil, Gas or Dry Hole) Dry hole
Date well completed February 17, 19 56
Application for plugging filed February 17, 19 56
Application for plugging approved February 17, 19 56
Plugging commenced February 17, 19 56
Plugging completed February 17, 19 56
Reason for abandonment of well or producing formation

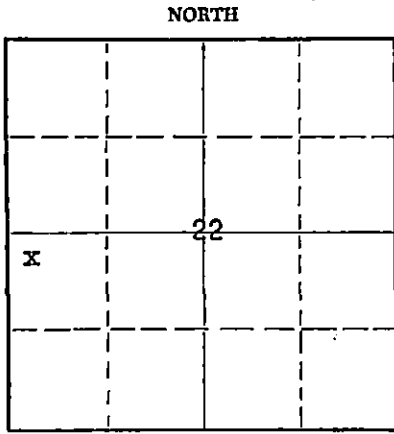

Locate well correctly on above Section Plat

If a producing well is abandoned, date of last production 19
Was permission obtained from the Conservation Division or its agents before plugging was commenced? yes

Name of Conservation Agent who supervised plugging of this well Mr. Milton Galyardt, Box 145, Russell, Kans.
Producing formation Depth to top Bottom Total Depth of Well 3203 Feet
Show depth and thickness of all water, oil and gas formations.

OIL, GAS OR WATER RECORDS

CASING RECORD

FORMATION	CONTENT	FROM	TO	SIZE	PUT IN	PULLED OUT
				8 5/8"	185'	none

Describe in detail the manner in which the well was plugged, indicating where the mud fluid was placed and the method or methods used in introducing it into the hole. If cement or other plugs were used, state the character of same and depth placed, from feet to feet for each plug set.

First plug set at 180' with 20 sacks cement
Second plug set at 40' with 10 sacks cement

2-27-56

RECEIVED
STATE CORPORATION COMMISSION
FEB 27 1956
CONSERVATION DIVISION
WICHITA, KANSAS

(If additional description is necessary, use BACK of this sheet)

Name of Plugging Contractor Anschutz Drilling Co., Inc.
Address 1 1/2 Mile High Center, Denver, Colorado

STATE OF Colorado, COUNTY OF Denver, ss.
E. G. Koelling (employee of owner) or (owner or operator) of the above-described well, being first duly sworn on oath, says: That I have knowledge of the facts, statements, and matters herein contained and the log of the above-described well as filed and that the same are true and correct. So help me God.

(Signature) E. G. Koelling
1 1/2 Mile High Center, Denver, Colo.
(Address)

SUBSCRIBED AND SWORN TO before me this 24th day of February, 1956

My commission expires October 4, 1959 Yvonne M. Robertson Notary Public.

PLUGGING
FILE SEC 22 T 12 R 15W
BOOK PAGE 39 LINE 38

DRILLER'S LOG

Anschutz Drilling Co., Inc.
No. 1 Schmeidler
NW NW SW Sec. 22-12S-15W
Russell County, Kansas

<u>FROM</u>	<u>TO</u>	
0	86	Post rock
86	195	Post rock & shale
195	775	Shale & red bed pyrite
775	810	Anhydrite
810	1025	Shale & shells
1025	1120	Salt & shale
1120	1240	Shale
1240	1535	Shale & shells
1535	1770	Lime & shale
1770	2150	Lime
2150	2330	Shale & lime
2330	2345	Torkio sand
2345	2595	Lime & shale
2595	3106	Lime
3106	3166	Lime & shale
3166	3203	Conglomerate
	3203	ROTARY TOTAL DEPTH

COMMENCED: February 7, 1956

COMPLETED: February 17, 1956

CASING RECORD:

Set 185' 8 5/8" casing with 175' sx cement.
2% cc

D & A

STATE OF COLORADO)
CITY AND COUNTY OF DENVER) SS

I hereby affirm that the above and foregoing is a true and correct copy of the log of the No. 1 Schmeidler located NW NW SW Section 22-12S-15W, Russell County, Kansas.

ANSCHUTZ DRILLING CO., INC.

By: *E. G. Koelling*
E. G. Koelling

Subscribed and sworn to before me this 21st day of February, 1956.

Yvonne M. Robertson
Yvonne M. Robertson
Notary Public

My Commission Expires: October 4, 1959

RECEIVED
STATE CORPORATION COMMISSION
FEB 27 1956
CONSERVATION DIVISION
Wichita, Kansas

PLUGGING
FILE SEC 22 12 15W
BOOK PAGE 39 LINE 38