


Give All Information Completely
Make Required Affidavit
Mail or Deliver Report to:
Conservation Division
State Corporation Commission
211 No. Broadway
Wichita, Kansas

Russell County, Sec. 14 Twp. 12S Rge. (E) 15 (W)

Location as "NE/CNW/SW" or footage from lines NW SE NE
Lease Owner The Globe Oil & Refining Co.
Lease Name Brandt Well No. 1
Office Address 301 S. Market, Wichita 2, Kansas
Character of Well (completed as Oil, Gas or Dry Hole) Dry Hole
Date well completed July 6 1957
Application for plugging filed July 8 1957
Application for plugging approved July 9 1957
Plugging commenced July 8 1957
Plugging completed July 8 1957
Reason for abandonment of well or producing formation Dry Hole

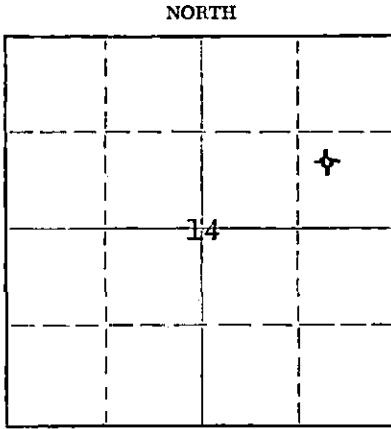

Locate well correctly on above Section Plat

If a producing well is abandoned, date of last production 19
Was permission obtained from the Conservation Division or its agents before plugging was commenced? Yes

Name of Conservation Agent who supervised plugging of this well Milton Galyardt, Box 145, Russell, Kansas.
Producing formation _____ Depth to top _____ Bottom _____ Total Depth of Well 3268 Feet
Show depth and thickness of all water, oil and gas formations. 3266 Sch. TD

OIL, GAS OR WATER RECORDS

CASING RECORD

FORMATION	CONTENT	FROM	TO	SIZE	PUT IN	PULLED OUT
				8 5/8	360	None

Describe in detail the manner in which the well was plugged, indicating where the mud fluid was placed and the method or methods used in introducing it into the hole. If cement or other plugs were used, state the character of same and depth placed, from _____ feet to _____ feet for each plug set.

Ran 100 sacks of cement in 8 5/8" surface pipe by Halliburton to plug hole. (7-6-57)
Checked hole on 7-8-57 and found cement down 5' from top. Filled hole on up with cement.

(If additional description is necessary, use BACK of this sheet)

Name of Plugging Contractor Sterling Drilling Co.
Address Sterling, Kansas

STATE OF Kansas, COUNTY OF Sedgwick, ss.
Leo Ross (employee of owner) or ~~(owner or operator)~~ of the above-described well, being first duly sworn on oath, says: That I have knowledge of the facts, statements, and matters herein contained and the log of the above-described well as filed and that the same are true and correct. So help me God.

(Signature) Leo Ross
301 So. Market, Wichita 2, Kansas
(Address)

SUBSCRIBED AND SWORN TO before me this 15th day of July, 1957

My commission expires July 21, 1958

Frances Leslie
Notary Public.

RECEIVED
STATE CORPORATION COMMISSION
7-16-57
JUL 16 1957

PLUGGING
FILE SEC 14 T. 12 R. 15W
BOOK PAGE 25 LINE 36

CONSERVATION DIVISION
WICHITA, KANSAS

GLOBE OIL & REFINING CO.
 No. 1 Brandt
 NW SE NE Sec. 14-12S-15W
 Russell County, Kansas

Date Commenced: June 24, 1957
 Date Completed: July 6, 1957
 Drilling Contractor: Sterling Drilling Co.
 Total Depth: 3268 Drillers (3266 Schlumberger T.D.)
 Initial Pot.: Dry and Abandoned

Formation	Depth
Surface	180
Shale	361
Shale & sand	800
Anhydrite	835
Shale & red bed	1010
Shale & lime	1765
Lime	1965
Shale & lime	2105
Lime & shale	2225
Shale & sand	2360
Shale & lime	2645
Lime	2820
Lime & shale	2870
Lime	3268

Casing Record:
 8-5/8" 360' Cem. 250 sacks

GEOLOGICAL TOPS - ROTARY BUSHING MEAS.

	(Sample)	(Schlumberger)
Anhydrite	800 (✓936)	806 (✓930)
Grandhaven	2301 (-565)	
Tarkio Lime	2375 (-639)	
Howard	2600 (-864)	2601 (-865)
Topoka	2636 (-900)	2637 (-901)
Heebner	2852 (-1116)	2852 (-1116)
Dodge	2873 (-1137)	2873 (-1137)
Douglas	2888 (-1152)	2888 (-1152)
Lansing	2905 (-1169)	2905 (-1169)
Cherty Conglomerate	3190 (-1454)	3192 (-1456)
Arbuckle	3218 (-1482)	3214 (-1478)
Total Depth	3268 (-1532)	3266 (-1530)

PLUGGING
 FILE SEC 14 T 12 R 15W
 BOOK PAGE 25 LINE 36

RECEIVED
 STATE OCCUPATION COMMISSION
 JUL 16 1957
 CON DIVISION