

15.167.00492.00.00

STATE OF KANSAS
STATE CORPORATION COMMISSION

WELL PLUGGING RECORD

Give All Information Completely
Make Required Affidavit
Mail or Deliver Report to:
Conservation Division
State Corporation Commission
800 Biting Building
Wichita, Kansas

FORMATION PLUGGING RECORD

Strike out upper line
when reporting plug-
ging of formations.

4290-S
3630-E

Russell County, Sec. 10 Twp. 12 Rge. 15 (E) (W)

Location as "NE $\frac{1}{4}$ NW $\frac{1}{4}$ SW $\frac{1}{4}$ " or footage from lines S.W. N.E. of N.W. $\frac{1}{4}$ Section

Lease Owner Maguire Industries Incorporated

Lease Name Brundage Well No. 1

Office Address 517 Union National Bank Bld'g. Wichita, Kansas

Character of Well (completed as Oil, Gas or Dry Hole) Dry

Date well completed 11 - 4 1944

Application for plugging filed 11 - 3 1944

Application for plugging approved 11 - 3 1944


Plugging commenced 11 - 3 1944

Plugging completed 11 - 4 1944

Reason for abandonment of well or producing formation Dry

If a producing well is abandoned, date of last production Not a producer 19

Was permission obtained from the Conservation Division or its agents before plugging was commenced? Yes

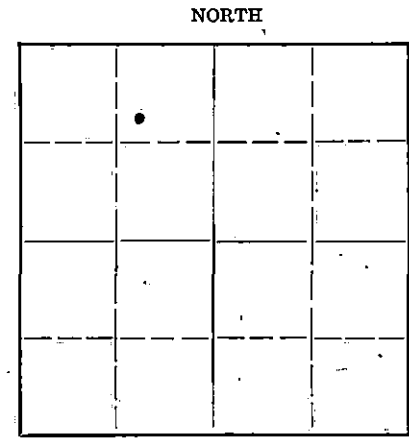

Locate well correctly on above
Section Plat

Name of Conservation Agent who supervised plugging of this well Mr. H. W. Curr

Producing formation Depth to top Bottom Total Depth of Well 3200 Feet

Show depth and thickness of all water, oil and gas formations.

OIL, GAS OR WATER RECORDS


CASING RECORD

Formation	Content	From	To	Size	Put In	Pulled Out
Top Anhydrite			723	13" O.D. 8-5/8" "	69' 732'	None cemented " " and circulated
" Dodge			2804			
" Kansas City			2834			
" Cherty Conglomerate			3130			
" Arbuckle			3162			

Describe in detail the manner in which the well was plugged, indicating where the mud fluid was placed and the method or methods used in introducing it into the hold. If cement or other plugs were used, state the character of same and depth placed, from feet to feet for each plug set.

Hole was filled with heavy mud from 3200' back up to within 700' of the top where a bridge was set and 15 sacks of cement was placed in the 8-5/8" casing this amount filling back up to 656' of the top. Heavy mud was placed from 656' back up to within 15' of the top of the 8-5/8" surface pipe where a bridge was placed and 10 sacks of cement was placed in the pipe and base of the cellar.

11-25-44

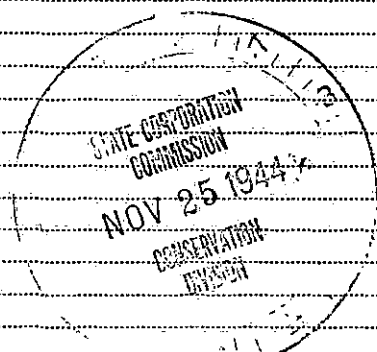

10 12 15W
139 18

(If additional description is necessary, use BACK of this sheet)

Correspondence regarding this well should be addressed to Maguire Industries incorporated c/o Gage W. Lee
Address 517 Union National Bank Bld'g. Wichita, Kansas

STATE OF Kansas, COUNTY OF Sedgwick, ss.
Gage W. Lee (employee of owner) or (~~owner or operator~~) of the above-described well,
being first duly sworn on oath, says: That I have knowledge of the facts, statements, and matters herein contained and the log of the above-described well as filed and that the same are true and correct. So help me God

(Signature) Gage W. Lee

517 Union National Bank Bld'g. Wichita, Kansas
(Address)

SUBSCRIBED AND SWORN to before me this 6 th. day of November, 1944

C. E. Grable
Notary Public.

My commission expires Jan 4, 1947

WELL LOG

Company: Maguire Industries, Inc.
 Lease: Brundage #1
 County: Russell
 Driller: Campbell & Kuhn
 Well Commenced: October 10, 1944
 Well Finished: November 4, 1944

Location: SW NE NW Sec. 10-12-15W
 Production: Dry *
 Total Depth: 3200
 Elevation: 1665
 Casing record: 12" 67
 8" 732

From	To	
0	35	Sand
35	80	Sand & Shale
80	140	Red Shale
140	250	Shale
250	300	Sand-Iron
300	340	Shale
340	415	Shale
415	705	Red Rock
705	723	Red Rock
723	725	Anhydrite
725	760	Anhydrite
760	1040	Shale & Shell
1040	1220	Shale & Shell
1220	1400	Shale
1400	1485	Lime & Shale
1485	1580	Shale & Lime
1580	1670	Shale & Lime
1670	1728	Shale & Lime
1728	1795	Lime
1795	1820	Lime & Shale
1820	1885	Broken Lime
1885	1964	Lime & Shale
1964	1995	Lime & Shale
1995	2040	Lime
2040	2055	Shale
2055	2100	Lime & Shale
2100	2185	Shale & Lime
2185	2255	Shale & Lime
2255	2320	Lime & Shale
2320	2380	Shale & Lime
2380	2410	Shale & Lime
2410	2460	Shale & Lime
2460	2520	Shale & Lime
2520	2560	Shale & Lime
2560	2580	Lime
2580	2612	Lime & Shale
2612	2647	Lime & Shale
2647	2681	Lime & Shale
2681	2704	Lime & Shale
2704	2726	Lime & Shale
2726	2759	Lime & Shale
2759	2782	Lime
2782	2804	Lime
2804	2829	Lime & Shale
2829	2866	Lime
2866	2894	Lime
2894	2924	Lime
2924	2949	Lime
2949	2963	Lime
2963	2983	Lime
2983	2997	Lime
2997	3021	Lime
3021	3052	Lime
3052	3075	Lime
3075	3089	Lime
3089	3091	Lime
3091	3110	Lime & Shale
3110	3133	Lime
3133	3163	Lime & Shale
3163	3192	Lime & Shale
3192	3200	T. D.

Shows:

Very light stain	2746-52
Very light stain	2756-58
Light saturation	2839-44
Light spotted saturation	2879-82
Light spotted stains	3162-80

Tops:

Hebner shale	2782
Dodge	2804
Lansing	2834
Cherty conglomerate	3130
Arbuckle	3162

I hereby certify that this is a true and correct copy of the log of the above mentioned well.

CAMPBELL & KUHN

Walter Kuhn

STATE OF KANSAS)
 COUNTY OF Adair) ss.

Subscribed and sworn to before me, A Notary Public in said County and State this 21st day of November, 1944.

Leota Foreman
 Notary Public

My Commission expires: 6-23-48

10 12 15W
 139 18

NOTARY PUBLIC
 STATE OF KANSAS
 NOV-25-1944