


Give All Information Completely
Make Required Affidavit
Mail or Deliver Report to:
Conservation Division
State Corporation Commission
211 No. Broadway
Wichita, Kansas

WELL PLUGGING RECORD

NORTH

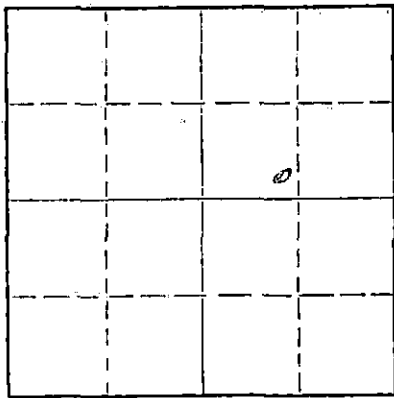

Locate well correctly on above
Section Plat

Russell County, Sec. 16 Twp. 12 Rge. 13 (E/W) (W)
Location as "NE/CNW/SW" or footage from lines. 100 1/2 N/SE SW NE
Lease Owner Waldo Valley Oil Co., Inc.
Lease Name Beatty Well No. 1
Office Address Osborne, Kansas
Character of Well (completed as Oil, Gas or Dry Hole) Dry Hole
Date well completed August 19 19 63
Application for plugging filed " 19 "
Application for plugging approved " 19 "
Plugging commenced " 19 "
Plugging completed " 19 "
Reason for abandonment of well or producing formation None

If a producing well is abandoned, date of last production None 19
Was permission obtained from the Conservation Division or its agents before plugging was commenced? Yes

Name of Conservation Agent who supervised plugging of this well Don Truan
Producing formation Depth to top Bottom Total Depth of Well 3160 Feet
Show depth and thickness of all water, oil and gas formations.

OIL, GAS OR WATER RECORDS

CASING RECORD

FORMATION	CONTENT	FROM	TO	SIZE	PUT IN	PULLED OUT
		0	157	8 5/8	157	-0-

Describe in detail the manner in which the well was plugged, indicating where the mud fluid was placed and the method or methods used in introducing it into the hole. If cement or other plugs were used, state the character of same and depth placed, from feet to feet for each plug set.

Hole was filled with mud to 300' 1/4 sack Hulls, plug and 20 sacks cement. Hole mudded to 150' 3/4 sack Hulls, plug and 20 sacks cement. Hole mudded to 40' 1/4 sack hulls, plug and 10 sacks cement.

Job completed - 2:00 P.M. 8-19-63

RECEIVED
STATE CORPORATION COMMISSION

AUG 20 1963

CONSERVATION DIVISION
Wichita, Kansas

8 20-63

(If additional description is necessary, use BACK of this sheet)

Name of Plugging Contractor Terrel Drilling and Producing
Address Russell, Kansas

STATE OF Kansas, COUNTY OF Russell, ss.
Joe K. Branum (employee of owner) or (owner or operator) of the above-described

well, being first duly sworn on oath, says: That I have knowledge of the facts, statements, and matters herein contained and the log of the above-described well as filed and that the same are true and correct. So help me God.

(Signature) Joe K. Branum
Joe K. Branum

(Address)

SUBSCRIBED AND SWORN to before me this 19th day of August, 19 63

My commission expires 12-12-66

R. Lee Simpson Notary Public.

INVOICED

DATE 8/21/63

INV. NO. 4630-W

W E L L L O G

OPERATOR: Waldo Valley Oil Co., Inc.
Osborne, Kansas

CONTRACTOR: Terrel Drilling & Producing
Russell, Kansas

LEASE: Beatty #1

LOCATION: SE SW NE Sec.16-12S-13W
Russell County, Kansas

COMMENCED: August 12, 1963

COMPLETED: August 19, 1963

DEPTHS AND FORMATIONS

Post Rock & Clay	150	Lime & Shale	2210
Sand & Shale	670	Shale	2640
Red Bed	790	Shale & Lime	2750
Anhydrite	830	Lime & Shale	2990
Shale & Shells	1825	Lime	3110
Shale & Lime	2165	Lime & Shale (R.T.D)	3160

RECEIVED
STATE CORPORATION COMMISSION

STATE OF KANSAS)
COUNTY OF RUSSELL) SS..

AUG 20 1963

CONSERVATION DIVISION
Wichita, Kansas

Joe K. Branum, owner of Terrel Drilling and Producing, being first duly sworn on oath says: "That I have knowledge of the facts, statements, and matters herein contained and the log of the above described well as filed and that the same are true and correct."

Joe K. Branum
Joe K. Branum

Subscribed and sworn before me this 19th day of August, 1963.

L. L. Simpson
Notary Public Russell County

My Commission Expires: December 12, 1966