

WELL PLUGGING RECORD

Give All Information Completely
Make Required Affidavit
Mail or Deliver Report to:
Conservation Division
State Corporation Commission
200 Bittling Building
Wichita, Kansas

Russell

County. Sec. 10 Twp. 15 Rge. 14 (E) W (W)

Location as "NE/CNW $\frac{1}{4}$ SW $\frac{1}{4}$ " or footage from lines C N/2 S/2 NW

Lease Owner Rudy A. Herman, Oil Operator

Lease Name E. Boxberger Well No. 2

Office Address Box 662, Russell, Kansas.

Character of Well (completed as Oil, Gas or Dry Hole) Dry Hole

Date well completed September 5, 1954 19

Application for plugging filed November 6, 1954 19

Application for plugging approved November 8, 1954 19


Plugging commenced November 8, 1954 19

Plugging completed November 10, 1954 19

Reason for abandonment of well or producing formation Dry

If a producing well is abandoned, date of last production 19

Was permission obtained from the Conservation Division or its agents before plugging was commenced? Yes

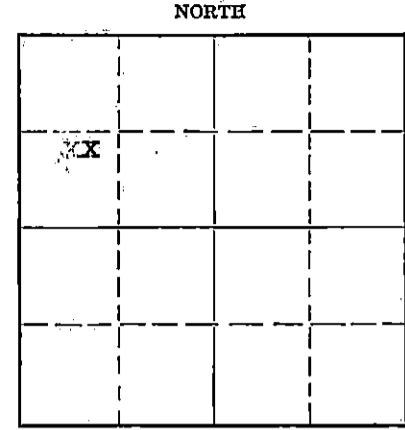

Locate well correctly on above Section Plot

Name of Conservation Agent who supervised plugging of this well Warren Horner

Producing formation Arbucle Depth to top 3227' Bottom 3230' Total Depth of Well 3230 Feet

Show depth and thickness of all water, oil and gas formations.

OIL, GAS OR WATER RECORDS

CASING RECORD

Formation	Content	From	To	Size	Put In	Pulled Out
Tario Sand	20bbl per hr water	2366'	2376'	8 5/8"	750'	Left in
Kansas City	Dry	2965'	3175'	5 1/2"	3228'	1726'
Conglomerate	Dry	3223'	3227'			
Arbucle	Dry	3227'	3230'			

Describe in detail the manner in which the well was plugged, indicating where the mud fluid was placed and the method or methods used in introducing it into the hole. If cement or other plugs were used, state the character of same and depth placed, from feet to feet for each plug set.

Set Lane Wells plug @ 3210' Set Lane Wells plug @ 2390'. Perforated @ 2355' to 2374'. Plugged back w/ crushed rock from 2390' to 2355' dumped 5 sacks of cement @ 2355' w/ dump bailer top of cement 2320'. Filled with Rotary Mud to 260' set 10' Rock Bridge dumped 20 sacks of cement top of cement 200', filled w/ mud to 35' set 10' rock bridge dumped 10 sacks of cement for cap.

(If additional description is necessary, use BACK of this sheet)

Name of Plugging Contractor

Address

STATE OF Kansas, COUNTY OF Russell, ss.

Part owner and operator (employee of owner) or (owner or operator) of the above-described well, being first duly sworn on oath, says: That I have knowledge of the facts, statements, and matters herein contained and the log of the above-described well as filed and that the same are true and correct. So help me God.

(Signature) Rudy A. Herman

Box 662, Russell, Kansas.


(Address)

SUBSCRIBED AND SWORN to before me this 29th day of November, 1954

Frances K. Christ

Notary Public.

My commission expires October 2, 1957

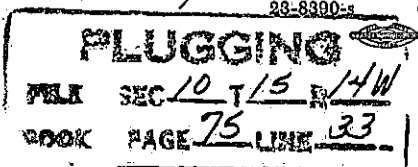

W E L L L O G

RUDY A. HERMAN
Russell, Kansas

Boxberger #2

Contractor: United Drilling, Inc.
Russell, Kansas

Section 10-15-14
Russell, Kansas

Commenced: August 27, 1954
Completed: September 6, 1954

Casing:
8 5/8" set at 769 feet

Depth	Formation
100 feet	Surface clay and sand
135 "	Sand, pyrites and shale
280 "	Sand, pyrites and shale
450 "	Red Bed
545 "	Red Bed and shells
764 "	Anhydrite
800 "	Shale and shells
1180 "	Salt and shale
1455 "	Shale and lime
1740 "	Lime
1975 "	Shale and lime
2680 "	Lime
2895 "	Shale and lime
2970 "	Lime
3232 "	Rotary Total Depth

I hereby certify that the above information is true and correct to the best of my knowledge.

Joan Hanes
Secy to Clyde G. Kissinger

SUBSCRIBED AND SWORN to before me this 15th day of November, 1954.

Margaret Zook
Notary Public

My Commission Expires: 10-30-57

