

STATE OF KANSAS  
STATE CORPORATION COMMISSION

Form CP-4


Give All Information Completely  
Make Required Affidavit  
Mail or Deliver Report to:  
Conservation Division  
State Corporation Commission  
211 No. Broadway  
Wichita, Kansas

WELL PLUGGING RECORD

Hodgeman County, Sec. 18 Twp. 24S Rge. 23 (E) W (W)

Location as "NE/CNW%SW%" or footage from lines C NW/4 NW/4  
Lease Owner Birmingham-Bartlett Drilling Co.  
Lease Name BRADFORD Well No. 1  
Office Address 300 Kaufman Bldg., Wichita, Kansas 67202  
Character of Well (completed as Oil, Gas or Dry Hole) Dry Hole  
Date well completed February 9, 19 66  
Application for plugging filed (Verbal) February 10, 19 66  
Application for plugging approved (Verbal) February 10, 19 66  
Plugging commenced February 10, 19 66  
Plugging completed February 10, 19 66  
Reason for abandonment of well or producing formation Dry Hole

NORTH

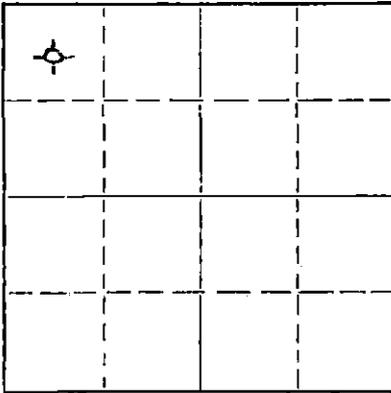

Locate well correctly on above  
Section Plat

If a producing well is abandoned, date of last production \_\_\_\_\_ 19\_\_\_\_  
Was permission obtained from the Conservation Division or its agents before plugging was commenced? Yes

Name of Conservation Agent who supervised plugging of this well Hugh Scott  
Producing formation \_\_\_\_\_ Depth to top \_\_\_\_\_ Bottom \_\_\_\_\_ Total Depth of Well 4844 Feet  
Show depth and thickness of all water, oil and gas formations.

OIL, GAS OR WATER RECORDS

CASING RECORD

FORMATION	CONTENT	FROM	TO	SIZE	PUT IN	PULLED OUT
		0	240'	8-5/8"	240'	none

Describe in detail the manner in which the well was plugged, indicating where the mud fluid was placed and the method or methods used in introducing it into the hole. If cement or other plugs were used, state the character of same and depth placed, from \_\_\_\_\_ feet to \_\_\_\_\_ feet for each plug set.

Plugged hole with heavy mud 4844' to 720' (35 sacks cement).  
720' to 620': heavy mud. 620' to 275': 35 sacks cement.  
275' to 175': mud. 175' to 45': plugged with hulls and 15 sacks cement.

RECEIVED  
STATE CORPORATION COMMISSION

FEB 14 1966

CONSERVATION DIVISION  
WICHITA, KANSAS

2-14-66

(If additional description is necessary, use BACK of this sheet)  
Name of Plugging Contractor Birmingham-Bartlett Drilling Co.  
Address 300 Kaufman Bldg., Wichita, Kansas 67202

STATE OF KANSAS, COUNTY OF SEDGWICK  
Richard Hindery, partner of Birmingham-Bartlett Drilling Co., owner, operator, & contractor  
well, being first duly sworn on oath, says: That I have knowledge of the facts, statements, and matters herein contained and the log of the above-described well as filed and that the same are true and correct. So help me God. BIRMINGHAM-BARTLETT DRILLING CO.

(Signature) By Richard Hindery Partner  
300 Kaufman Building, Wichita, Kansas 67202  
(Address)

SUBSCRIBED AND SWORN TO before me this 11th day of February, 19 66.

My commission expires October 2, 1966.

Beverly Larson  
Beverly Larson  
Notary Public.

BRADFORD NO. 1 WELL

LOCATION: C NW/4 NW/4  
Sec. 18-24S-23W  
Hodgeman County, Kansas

SPUDED: 1-26-66  
DRILLING  
COMPLETED: 2-9-66

OWNER, OPERATOR,  
and CONTRACTOR: Birmingham-Bartlett Drilling Co.  
300 Kaufman Building  
Wichita, Kansas 67202

SURFACE CASING: 8-5/8" 20# casing cemented at  
240' with 170 sacks cement.

OIL STRING: None set. Dry hole.  
Plugging completed 2-10-66.

L O G

(Figures indicate bottom of formation)

0 - 240	Surface soil
440	Shale and shells
503	Sand
1010	Shale and shells
1022	Blaine Anhydrite
1070	Shale and shells
1230	Sand
1325	Shale and shells
1500	Red bed
1614	Anhydrite
2015	Shale
2395	Shale and shells
3302	Lime and shale
3465	Shale
4075	Lime and shale
4337	Lime
4381	Lime and shale
4471	Lime
4536	Lime and shale
4567	Lime
4635	Lime and shale
4735	Lime
4763	Lime and chert
4844	Lime
4844	Rotary total depth D & A

RECEIVED  
STATE GEOLOGICAL COMMISSION  
FEB 14 1966  
CONSERVATION DIVISION  
Wichita, Kansas

The undersigned, Richard Hindery, one of the partners of Birmingham-Bartlett Drilling Co., hereby certifies that the above is a true and correct log of the BRADFORD NO. 1 WELL as shown in the daily drilling reports.

BIRMINGHAM-BARTLETT DRILLING CO.

By Richard Hindery  
Richard Hindery, Partner

Subscribed and sworn to before me  
this 11th day of February, 1966.

Beverly Larson  
Beverly Larson, Notary Public  
My commission expires October 2, 1966.