

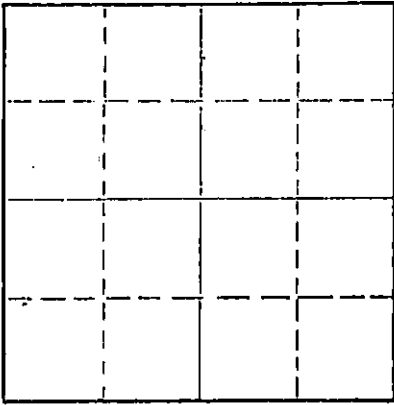
STATE OF KANSAS
STATE CORPORATION COMMISSION

Form CP-4

Give All Information Completely
Make Required Affidavit
Mail or Deliver Report to:
Conservation Division
State Corporation Commission
211 No. Broadway
Wichita, Kansas

WELL PLUGGING RECORD

NORTH

Locate well correctly on above
Section Plot

Hodgeman

County. Sec. 18 Twp. 24S Rge. 23 (E) (W) X

Location as "NE/CNW/SW" or footage from lines SE NW

Lease Owner Thunderbird Drilling, Inc.

Lease Name Bradford "A"

Well No. 1

Office Address P. O. Box 18407- Wichita, Kansas 67218

Character of Well (completed as Oil, Gas or Dry Hole) Dry Hole

Date well completed 5/20/76 19

Application for plugging filed 5/20/76 19

Application for plugging approved 5/20/76 19

Plugging commenced 5/20/76 19

Plugging completed 5/20/76 19

Reason for abandonment of well or producing formation

If a producing well is abandoned, date of last production 19

Was permission obtained from the Conservation Division or its agents before plugging was commenced?

Name of Conservation Agent who supervised plugging of this well Leo Massey

Producing formation Depth to top Bottom Total Depth of Well 4875 Feet

Show depth and thickness of all water, oil and gas formations.

OIL, GAS OR WATER RECORDS

CASING RECORD

FORMATION	CONTENT	FROM	TO	SIZE	PUT IN	PULLED OUT
Surface		0	502'	8 5/8"	502'	0

Describe in detail the manner in which the well was plugged, indicating where the mud fluid was placed and the method or methods used in introducing it into the hole. If cement or other plugs were used, state the character of same and depth placed, from feet to feet for each plug set.

1st Plug @ 660' w/50 sx,

2nd Plug @ 300' w/25 sx

3rd Plug @ 40' w/10 sx

6-2-76

RECEIVED
STATE CORPORATION COMMISSION

JUN 02 1976

CONSERVATION DIVISION
WICHITA, KANSAS

(If additional description is necessary, use BACK of this sheet)

Name of Plugging Contractor Thunderbird Drilling, Inc.

Address P. O. Box 18407- Wichita, Kansas 67218

STATE OF KANSAS, COUNTY OF SEDGWICK, ss.
Burke Krueger

(employee of owner) or (owner or operator) of the above-described well, being first duly sworn on oath, says: That I have knowledge of the facts, statements, and matters herein contained and the log of the above-described well as filed and that the same are true and correct. So help me God.

(Signature)

P. O. Box 18407- Wichita, Kansas 67218

(Address)

SUBSCRIBED AND SWORN TO before me this 25th day of May, 1976

My commission expires 3-25-80

Gloria DeJesus

Gloria DeJesus

Notary Public.



DRILLERS LOG

Company Thunderbird Drilling, Inc. Contractor Thunderbird Drilling, Inc.
Elevation 2465 K.B.
Farm Bradford "A"
Well No. 1 Casing 8 5/8" @ 502' w/300 sx
Location SE NW
 18-24S-23W
County Hodgeman Production

<u>From</u>	<u>To</u>	<u>Description</u>
0	30	Sod
30	75	Postrock
75	327	Shale
327	345	Sand
345	375	Shale & Shells
375	1090	Shale
1090	1290	Sand
1290	1593	Shale
1593	1612	Anhydrite
1612	2182	Shale & Shells
2182	4275	Shale & Lime
4275	4767	Lime & Shale
4767	T.D.	Lime

RECEIVED
STATE CORPORATION COMMISSION

JUN 02 1976

CONSERVATION DIVISION
Wichita, Kansas

STATE OF KANSAS)
) ss.
 COUNTY OF SEDGWICK)

I, Burke Krueger, of Thunderbird Drilling, Inc. upon oath states that the above and foregoing is a true and correct copy from the Daily Drilling Report from your #1 Bradford "A".

Burke Krueger

Subscribed and sworn to before me this 25th day of May, 1976.

Gloria DeJesus

Gloria DeJesus Notary Public

My commission expires: 3-25-80

