


STATE OF KANSAS  
STATE CORPORATION COMMISSION

WELL PLUGGING RECORD

Give All Information Completely  
Make Required Affidavit  
Mail or Deliver Report to  
Conservation Division  
State Corporation Comm.  
245 North Water  
Wichita, KS 67202

Hodgeman County. Sec. 18 Twp. 24 Rge. 23 E/W  
Location as "NE/CNW $\frac{1}{2}$ SW $\frac{1}{2}$ " or footage from lines  
C of NE NW  
Lease Owner Thunderbird Drilling, Inc.  
Lease Name Bradford A#2 Well No.  
Office Address Ellinwood, Kansas 67526  
Character of Well (Completed as Oil, Gas or Dry Hole)

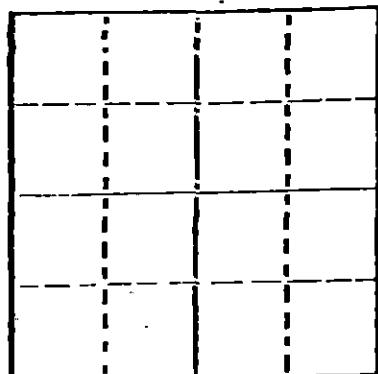

Locate well correctly as above  
Section 18

Date Well completed 19  
Application for plugging filed 19  
Application for plugging approved 19  
Plugging commenced 6/23/76 19  
Plugging completed 7/1/76 19  
Reason for abandonment of well or producing formation  
depleted.

If a producing well is abandoned, date of last production 19

Was permission obtained from the Conservation Division or  
its agents before plugging was commenced? yes

Name of Conservation Agent who supervised plugging of this well Thomas  
Producing formation Depth to top Bottom Total Depth of Well 4950  
Show depth and thickness of all water, oil and gas formations.

OIL, GAS OR WATER RECORDS

CASING RECORD

FORMATION	CONTENT	FROM	TO	SIZE	PUT IN	PULLED OUT
				8-5/8	325	none
				4 1/2	4883	2352'

Describe in detail the manner in which the well was plugged, indicating where the mud fluid was placed and the method or methods used in introducing it into the hold. If cement or other plugs were used, state the character of same and depth placed, from feet to feet for each plug set.

Squeezed bottom hole with 35 sacks cement. Pumped plug to 4525', 1200' standing pressure. Shot pipe at 4240', 4030', 3905', spotted 50 barrels oil and pumped plug to 3850'. Shot pipe at 2713', worked shot, unable to make it go down, started to pull shot out of hole when shot went out at 2325', pulled 56 joints of 4 1/2" casing. Squeezed well with 3 sacks hulls, 10 sacks gel, 50 sacks cement, 10 sacks gel, released plug and ran 35 sacks cement, 10 sacks gel, displaced with 15 sacks cement.

PLUGGING COMPLETE.

(If additional description is necessary, use BACK of this sheet)

Name of Plugging Contractor KELSO CASING PULLING  
CHASE, KANSAS

CONSERVATION DIVISION  
WICHITA, KANSAS

7-8-76

STATE OF KANSAS COUNTY OF RICE  
R. DARRELL KELSO


(employee of owner) or (owner or operator) of the above-described well, being first duly sworn on oath, says: That I have knowledge of the facts, statements, and matters herein contained and the log of the above-described well as filed and that the same are true and correct. So help me God.

(Signature) R. Darrell Kelso  
CHASE, KANSAS

(Address)

SUBSCRIBED AND SWORN TO before me this 5th day of July 1976

My commission expires

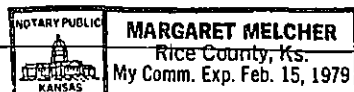

Margaret Melcher  
Notary Public