


STATE OF KANSAS
STATE CORPORATION COMMISSION

Give All Information Completely
Make Required Affidavit
Mail or Deliver Report to:
Conservation Division
State Corporation Commission
211 No. Broadway
Wichita, Kansas

WELL PLUGGING RECORD

NORTH

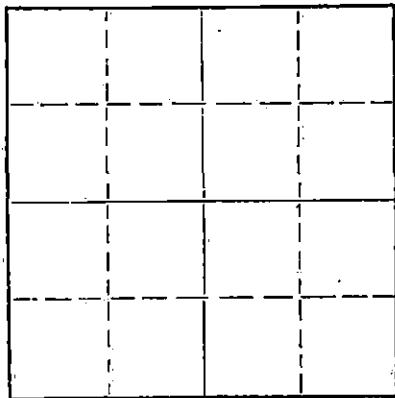

Locate well correctly on above
Section Plat

Stafford County, Sec. 3, Twp. 24S Rge. (E) 15(W)

Location as "NE/CNW/SW" or footage from lines SE/4
Lease Owner White & Ellis Drilling, Inc.
Lease Name Cornwell #1 Well No.
Office Address P. O. Box 448 - El Dorado, Kansas
Character of Well (completed as Oil, Gas or Dry Hole) Dry Hole
Date well completed April 26, 1961
Application for plugging filed April 26, 1961
Application for plugging approved April 26, 1961
Plugging commenced April 26, 1961
Plugging completed April 26, 1961
Reason for abandonment of well or producing formation Dry Hole

If a producing well is abandoned, date of last production 19
Was permission obtained from the Conservation Division or its agents before plugging was commenced? Yes

Name of Conservation Agent who supervised plugging of this well Donald Truan
Producing formation _____ Depth to top _____ Bottom _____ Total Depth of Well 4160 Feet
Show depth and thickness of all water, oil and gas formations.

OIL, GAS OR WATER RECORDS

CASING RECORD

FORMATION	CONTENT	FROM	TO	SIZE	PUT IN	PULLED OUT
				8 5/8	249'	None

Describe in detail the manner in which the well was plugged, indicating where the mud fluid was placed and the method or methods used in introducing it into the hole. If cement or other plugs were used, state the character of same and depth placed, from _____ feet to _____ feet for each plug set.

Hole filled with heavy rotary mud to 240 feet. Bridge at 240 feet with 25 sacks cement on bridge. Hole filled with heavy rotary mud to 40 feet. Bridge at 40 feet with 10 sacks cement on bridge. Rat hole filled with heavy rotary mud and capped with 2 sacks cement.

RECEIVED
STATE CORPORATION COMMISSION

MAY 3 1961

CONSERVATION DIVISION
Wichita, Kansas

5-3-61

(If additional description is necessary, use BACK of this sheet)
Name of Plugging Contractor White & Ellis Drilling, Inc. - License #209
Address Box 448 - El Dorado, Kansas

STATE OF Kansas, COUNTY OF Butler, ss.
Ernest Sifford, employee of Contractor (employee of owner, or owner or operator) of the above-described well, being first duly sworn on oath, says: That I have knowledge of the facts, statements, and matters herein contained and the log of the above-described well as filed and that the same are true and correct. So help me God.

(Signature) Ernest Sifford
Box 448 - El Dorado, Kansas
(Address)

SUBSCRIBED AND SWORN TO before me this 28th day of May, 1961

My commission expires September 26th, 1964

L. B. Auer
Notary Public.

15-185-10484-0000
*Jim Hershberger
Sw Sw Se*

Casing Record

8 5/8

249' Cemented
w/185 sacks

Location: SE/4
Section: 3-24S-15W
Stafford County, Kansas
Farm: Cornwell #1
Well Owner: White & Ellis et al
Contractor: White & Ellis Drig., Inc.
Started: 4/15/61

T.D.

4160'

Kelly Bushing Measurement 5' above ground level.

FORMATION	DEPTH
Soil	0-10
Shale	290
Sand	310
Red rock	445
Sand	485
Red rock	960
Anhydrite	990
Shale	1240
Shale & Anhydrite	1795
Lime	2265
Lime & Shale	2970
Lime	3549
Shale	3650
Lime	3884
Lime & Shale	3988
Lime	4063
Shale	4094
Shale	4139
Lime	4160

TOPS

Heebner	3512
Brown	3649
Lansing-Kansas City	3657
Mississippi	3985
Simpson	4063
Arbuckle	4139

Dry Hole
Plugged & Abandoned

RECEIVED
STATE CORPORATION COMMISSION
MAY 3 1961
CONSERVATION DIVISION
Wichita, Kansas