

STATE OF KANSAS
STATE CORPORATION COMMISSION


WELL PLUGGING RECORD

Give All Information Completely
Make Required Affidavit

Mail or Deliver Report to:
Conservation Division
State Corporation Commission
800 Bittling Building
Wichita, Kansas

Stafford County. Sec. 3 Twp. 24 Rge. 15 (E) W (W)
Location as "NE/CNW $\frac{1}{4}$ SW $\frac{1}{4}$ " or footage from lines SE SE SE 330FSL & 330 FEL
Lease Owner J. J. Lynn
Lease Name Cornwell Well No. 1
Office Address P. O. Box 2199, Abilene, Texas
Character of Well (completed as Oil, Gas or Dry Hole) Gas
Date well completed May 2 19 44
Application for plugging filed October 19 19 53
Application for plugging approved October 20 19 53
Plugging commenced October 24 19 53
Plugging completed October 31 19 53
Reason for abandonment of well or producing formation Gas zone was plugged off by excessive water
If a producing well is abandoned, date of last production January 19 53
Was permission obtained from the Conservation Division or its agents before plugging was commenced? YES

NORTH

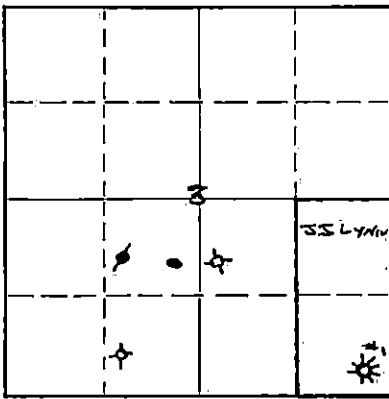

Locate well correctly on above Section Plat

Name of Conservation Agent who supervised plugging of this well
Producing formation Arbuckle Depth to top 4103 Bottom 4121 Total Depth of Well 4109 Feet
Show depth and thickness of all water, oil and gas formations.

OIL, GAS OR WATER RECORDS

CASING RECORD

Formation	Content	From	To	Size	Put In	Pulled Out
Kansas City	Oil show	3649	3920	10-3/4	240	0
Mammaton	Dry	3920	3922			
Arbuckle	Gas & water	4103	4121	5 1/2	4116'	2145'

Describe in detail the manner in which the well was plugged, indicating where the mud fluid was placed and the method or methods used in introducing it into the hole. If cement or other plugs were used, state the character of same and depth placed, from _____ feet to _____ feet for each plug set.

Measured in to total depth of 4109'

Dumped 30 sacks cement and 30 sacks mud.

Shot casing off at 2160'. Pulled casing out of hole. Squeezed surface casing w/30 sacks mud and pumped in 120 sacks cement.

Work started October 24, 1953. Completed October 31, 1953.

Plugging Contractor - Forbes Casing Pullers
Great Bend, Kansas

(If additional description is necessary, use BACK of this sheet)

Correspondence regarding this well should be addressed to J. J. Lynn
Address P. O. Box 2199, Abilene, Texas

STATE OF Texas COUNTY OF Taylor ss:
G. R. Meyers (employee of owner) or (owner or operator) of the above-described well,
being first duly sworn on oath, says: That I have knowledge of the facts, statements, and matters herein contained and the log of the above-described well as filed and that the same are true and correct. So help me God.

(Signature) *G. R. Meyers*

P. O. Box 2199, Abilene, Texas
(Address)

SUBSCRIBED AND SWORN to before me this 16th day of November, 1953.

Alta Nation
Notary Public.

My commission expires 6-1-55

22-7877-8 4-49-10M

PLUGGING
FILE SEC 3 T 24 R 15W
BOOK PAGE 132 LINE 4

11-18-53

J. J. LYNN
Cornwell #1

Sec. 3, T24, R15W
SE SE SE
Stafford County, Kansas

Total Depth 4121
Comm. with rotary 3-17-44
Comp. with rotary 4-6-44
Comm. with cable tools 4-13-44
Comp. with cable tools 5-3-44
Contractor H. M. Williams

Casing
10-3/4" 240
5 1/2" 4116

Sand	150
Shale & red bed	240
red bed, shale & shells	815
shale	925
anhydrite	950
shale	1150
Shale & shells	1865
lime & shale	1955
lime	2085
lime & shale	2150
lime	2275
lime & shale	2915
shale & shells	2965
shale & lime	3170
lime	3205
lime & shale	3275
shale & shells	3313
lime & shale	3475
lime	3500
lime & shale	3649
lime	3920
lime & shale (Marmaton)	3979
Cherty Conglomerate at	3979
" "	3992
Viola	4051
Simpson	4103
Arbuckle lime	4121

Top Lansing-Kansas City 3649
Base " " " 3920
Drill stem test at 3823 showed
15' rotary mud
Top Marmaton 3920
Top Viola 3992
Top Simpson 4051
Top Arbuckle 4103

Halliburton drill stem test
with packer set at 4105 showed
gas pressure over 1000 lbs
and 85' of mud and sulphur water

Plugged back to 4109 and perforated
casing with 5 1/8" holes from
4108'6" to 4107' and acidized with
2000 gal. acid. Gas estimated
between 5 and 10 million feet and
some oil. No test has been made as
to amount of production due to no
outlet for sale of gas.

PLUGGING
FILE SEC 3 T 24 R 15W
BOOK PAGE 132 LINE 4

RECEIVED
STAFFORD COUNTY COMMISSION
NOV 17 1943
JAMES W. ...
Mickler, ...