

STATE OF KANSAS
STATE CORPORATION COMMISSION

WELL PLUGGING RECORD
OR
FORMATION PLUGGING RECORD

Strike out upper line
when reporting plug-
ging off formations.

Give All Information Completely
Make Required Affidavit
Mail or Deliver Report to:
Conservation Division
State Corporation Commission
800 Bitting Building
Wichita, Kansas

Stafford County, Sec. 3 Twp. 24 Rge. (E) 15 (W)

Location as "NE 1/4 NW 1/4 SW 1/4" or footage from lines SW 1/4 660' of S Line, 990' of E L

Lease Owner J. J. Lynn

Lease Name W. Nagel Well No. 1

Office Address 701 Bitting Bldg., Wichita, Kansas

Character of Well (completed as Oil, Gas or Dry Hole) Dry

Date well completed Oct. 12 19 41

Application for plugging filed Oct. 13 19 41

Application for plugging approved Oct. 13 19 41


Plugging commenced Oct. 13 19 41

Plugging completed Oct. 15 19 41

Reason for abandonment of well or producing formation Dry

If a producing well is abandoned, date of last production 19

Was permission obtained from the Conservation Division or its agents before plugging was com-
menced? Yes

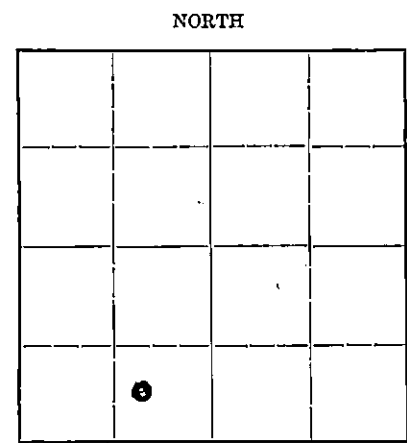

Locate well correctly on above
Section Plat

Name of Conservation Agent who supervised plugging of this well C. T. Alexander

Producing formation Kansas City Lime Depth to top 3630 Bottom 3844 Total Depth of Well 3844 Feet

Show depth and thickness of all water, oil and gas formations.


OIL, GAS OR WATER RECORDS

CASING RECORD

Formation	Content	From	To	Size	Put In	Pulled Out
Shale and sand		10	315	10	280	None
Lime and shale		3448	3814	6 5/8	3814	1866
	Salt water at		3822			
	Light show oil at		3816			

Describe in detail the manner in which the well was plugged, indicating where the mud fluid was placed and the method or methods used in introducing it into the hole. If cement or other plugs were used, state the character of same and depth placed, from...feet to ...feet for each plug set.

Hole filled with mud from 3844 to 3814. Plug set at 3814 and cement put in with dump bailer to 3794. Mud put in hole from 3794 to 280. Plug set at 280' and cement put in with dump bailer to 260. Mud put in hole from 260 to 30'. Plug set at 30' and cemented to 8' and mud from 8' to surface

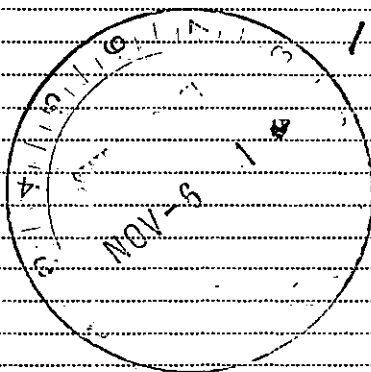

11-6-41

3 24 15W
11 - 251

(If additional description is necessary, use BACK of this sheet)

Correspondence regarding this well should be addressed to J. J. Lynn, Care of Williams & Wilson

Address 701 Bitting Bldg., Wichita, Kansas

STATE OF Kansas, COUNTY OF Sedgwick, ss.

H. M. Williams (employee of owner) or (owner or operator) of the above-described well,

being first duly sworn on oath, says: That I have knowledge of the facts, statements, and matters herein contained and the log of the above-described well as filed and that the same are true and correct. So help me God.

(Signature)

H. M. Williams
701 Bitting Bldg. Wichita, Kan

SUBSCRIBED AND SWORN to before me this 18th day of October, 1941

[Signature]

Notary Public.

My commission expires March 4-1944




WELL LOG BUREAU - KANSAS GEOLOGICAL SOCIETY.
412 Union National Bk Bldg, Wichita, Kansas.

J. J. LYNN.
Nagle No. 1.

SEC. 3 T. 24 R. 15W.
CWL SE SW

Total Depth. 3844
Comm. 9-13-41 Comp. 10-30-41
Shot or Treated.
Contractor. W.W. Drilling Co.
Issued. 11-8-41

County Stafford.

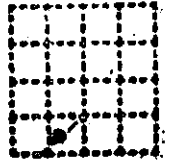

CASING.

103/4" 280' cemented.
65/8" 3815'


Elevation.

Production. DRY.

Figures Indicate Bottom of Formations.

sand and shalo	315
rod rock and sand	614
rod rock shale & anhydrite	964
shale and shells	1161
shale and shells	1335
shale and salt	1520
shale and shells	1820
shale and lime and strks salt	1925
lime and shale broken	2010
lime broken	2095
lime and shalo	2270
shalo	2350
shale and lime	2970
lime	2983
lime and shale	3073
broken lime and shale	3132
lime and shale	3273
shalo	3278
shale and lime	3371
lime	3448
shale and lime	3814
cored 3814-27	
cored 3827-44	
sand	3825
lime	3844

Total Depth.

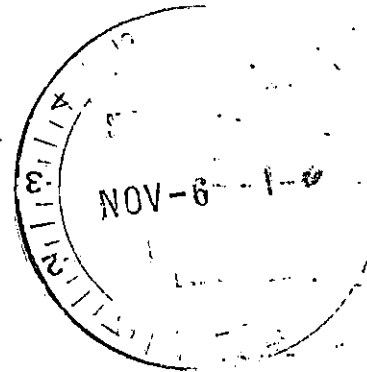

FIL	3 24 15W
300	11 23