

AFFIDAVIT OF COMPLETION FORM

ACO-1

This form shall be filed in triplicate with the Kansas Corporation Commission, 200 Colorado Derby Building, Wichita, Kansas 67202, within ten days after the completion of the well, regardless of how the well was completed. Circle one: Oil, gas, dry, SWD, OWWO, injection. Type and complete ALL sections. Applications must be filed for dual completion, commingling, salt water disposal and injection. Attach wireline logs (i.e. electrical log, sonic log, gamma ray neutron log, etc.) KCC#-(316)263-3238.

OPERATOR Associates Oil & Gas, Inc.

API NO. 15-079-20,559-0600

ADDRESS 555 N. Woodlawn Suite 114

COUNTY Harvey

Wichita, Kansas 67208

FIELD SCHRAG

\*\*CONTACT PERSON J. D. Gebert

PROD. FORMATION Kansas City-Swope

PHONE \_\_\_\_\_

LEASE Schrag

PURCHASER Clear Creek

WELL NO. 4A

ADDRESS 818 Century Plaza Bldg.

WELL LOCATION SE SW NE

Wichita, KS 67202

330 Ft. from south Line and

DRILLING White & Ellis Drilling


\_\_\_\_\_ Ft. from \_\_\_\_\_ Line of

CONTRACTOR ADDRESS 401 E. Douglas # 500

the 10 SEC. 24 TWP. 3 RGE. W

Wichita, KS 67202

PLUGGING NA

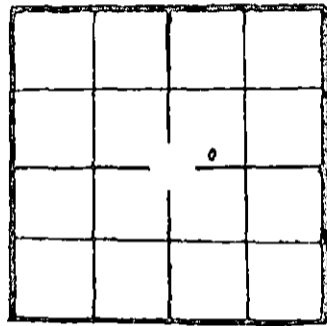

WELL PLAT

CONTRACTOR ADDRESS \_\_\_\_\_

KCC   
KGS   
MISC   
(Office Use)

TOTAL DEPTH RTD 3020 PBD \_\_\_\_\_

SPUD DATE 4-12-82 DATE COMPLETED 4-21-82

ELEV: GR 1432 DF \_\_\_\_\_ KB 1437

DRILLED WITH ~~XXXXX~~ (ROTARY) ~~XXXXX~~ TOOLS (New) / (Used) casing.

CASING RECORD

Report of all strings set — surface, intermediate, production, etc.

Purpose of string	Size hole drilled	Size casing set (in O.D.)	Weight lbs/ft.	Setting depth	Type cement	Sacks	Type and percent additives
Conductor		20 3/8		253	Poz	250	3%CaCl 2% gel
Surface		8 5/8		587	Common	300	3%CaCl 2% gel
Production		4 1/2		3009	Common	75	2%CaCl 2% gel

LINER RECORD			PERFORATION RECORD		
Top, ft.	Bottom, ft.	Sacks cement	Shots per ft.	Size & type	Depth interval
			3		2967-2969
TUBING RECORD					
Size	Setting depth	Packer set at			

ACID, FRACTURE, SHOT, CEMENT SQUEEZE RECORD

Amount and kind of material used	Date treated
No treatments - Natural	JUL 28 1982

RECEIVED  
STATE CORPORATION COMMISSION  
CONSERVATION DIVISION  
Wichita, Kansas  
7-28-82

Date of first production 4-30-82 Producing method (flowing, pumping, gas lift, etc.) Pumping Gravity \_\_\_\_\_

RATE OF PRODUCTION PER 24 HOURS Oil \_\_\_\_\_ Gas \_\_\_\_\_ Water % Gas-oil ratio \_\_\_\_\_ CFPB \_\_\_\_\_

Disposition of gas (vented, used on lease or sold) \_\_\_\_\_ Perforations \_\_\_\_\_

\*\*The person who can be reached by phone regarding any questions concerning this information. A witnessed initial test by the Commission is required if the well produces more than 25 BOPD or is located in a Basic Order Pool.

Name of lowest fresh water producing stratum \_\_\_\_\_ Depth \_\_\_\_\_

Estimated height of cement behind Surface Pipe \_\_\_\_\_

DV USED? \_\_\_\_\_

WELL LOG

Formation Description, Contents, etc.	Top	Bottom	Name	Depth
	- 923		Heebner	2360
	- 973		Toronto	2410
	- 966		Douglas	2433
	- 1103		Brown Lime	2540
	- 1135		Lansing	2572
	- 1521		Stark Shale	2958
	- 1529		Swope	2966
	-1578		LTD	3020
DST #1: Initial Flow 30 Minutes Initial Shut In Pressure 45 Minutes Final Flow 60 Minutes Final Shut In Pressure 45 Minutes Very strong blow both openings Gas to surface 45 minutes to strong to measure Recovered: 300' clean gassy oil (34° A.P.I. at 60° F) 120' heavy oil and gas cut mud 120' oil cut mud 1560' slightly oil cut water ISIP: 1009#/ 45 Minutes FSIP: 1009#/ 45 Minutes Flow Pressures: 321# - 689# / 748# - 930#				

A F F I D A V I T

STATE OF Kansas, COUNTY OF Sedgwick SS, \_\_\_\_\_

J. D. Gebert OF LAWFUL AGE, BEING FIRST DULY SWORN UPON HIS OATH,

DEPOSES THAT HE IS President (FOR)(OF) Associates Oil & Gas, Inc.

OPERATOR OF THE Schrag LEASE, AND IS DULY AUTHORIZED TO MAKE

THIS AFFIDAVIT FOR AND ON THE BEHALF OF SAID OPERATOR, THAT WELL NO. 4A ON

SAID LEASE HAS BEEN COMPLETED AS OF THE 21 DAY OF April, 1982, AND THAT

ALL INFORMATION ENTERED HEREIN WITH RESPECT TO SAID WELL IS TRUE AND CORRECT.

FURTHER AFFIANT SAITH NOT.

(S) J. D. Gebert  
 July 27 19 82

SUBSCRIBED AND SWORN TO BEFORE ME THIS \_\_\_\_\_ DAY OF \_\_\_\_\_ 19 \_\_\_\_\_

Cynthia L. Jackson  
 NOTARY PUBLIC  
 Cynthia L. Jackson

RECEIVED  
 STATE COMMISSION  
 JUL 28 1982  
 MY COMMISSION EXPIRES ME THIS \_\_\_\_\_ DAY OF \_\_\_\_\_ 19 \_\_\_\_\_  
 CONSERVATION DIVISION  
 Wichita, Kansas 09-25-82

