


Give All Information Completely
Make Required Affidavit
Mail or Deliver Report to:
Conservation Division
State Corporation Commission
800 Bittling Building
Wichita, Kansas

OR
FORMATION PLUGGING RECORD

Strike out upper line
when reporting plug-
ging of formations.

NORTH

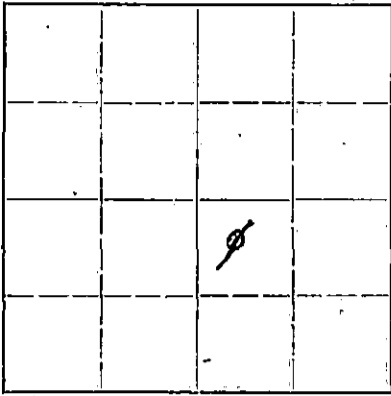

Locate well correctly on above
Section Plat

Russell County. Sec 3 Twp 15 Rge. (B) 15 (W)
Location as "NE1/4NW1/4SW1/4" or footage from lines NW NW SE
Lease Owner Cooperative Refinery Association
Lease Name Streck "B" 1 Well No 1
Office Address 402 Schweiter Bldg., Wichita, Kansas
Character of Well (completed as Oil, Gas or Dry Hole) Dry Hole
Date well completed 10-13 19 47
Application for plugging filed 10-24 19 "
Application for plugging approved 10-27 19 "
Plugging commenced 10-27 19 "
Plugging completed 10-29 19 "
Reason for abandonment of well or producing formation Dry hole

If a producing well is abandoned, date of last production 19
Was permission obtained from the Conservation Division or its agents before plugging was com-
menced? Yes

Name of Conservation Agent who supervised plugging of this well W. H. Kerr
Producing formation none Depth to top Bottom Total Depth of Well 3324 Feet
Show depth and thickness of all water, oil and gas formations.

OIL, GAS OR WATER RECORDS

CASING RECORD

Formation	Content	From	To	Size	Put In	Pulled Out
				8 5/8"	878'	00
				5 1/2"	3317'	2522'

Describe in detail the manner in which the well was plugged, indicating where the mud fluid was placed and the method or methods used in introducing it into the hold. If cement or other plugs were used, state the character of same and depth placed, from feet to feet for each plug set.

Eight sacks cement on mud and chatt at 3160', mudded to 900', run 60 sacks cement with Halliburton, mudded to 200', run 10 sacks cement, mudded to within 30' of surface, run 15 sacks cement which filled up to bottom of cellar, filled cellar to surface.

11-12-47


(If additional description is necessary, use BACK of this sheet)

Correspondence regarding this well should be addressed to
Address

STATE OF Kansas COUNTY OF Sedgewick, SS.
O. W. Gosnell (employee of owner) or (owner or operator) of the above-described well,
being first duly sworn on oath, says: That I have knowledge of the facts, statements, and matters herein contained and the log of the above-described well as filed and that the same are true and correct. So help me God.

(Signature) O. W. Gosnell
402 Schweiter Bldg., Wichita, Kansas
(Address)

SUBSCRIBED AND SWORN to before me this 11th day of November, 1947
Ruth Love
Notary Public.

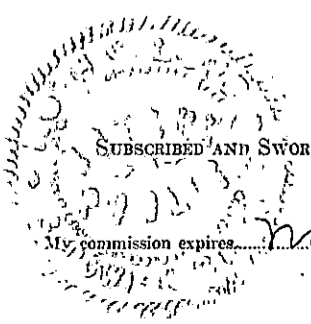

PLUGGING
FILE SEC 3 T 15 R 15 W
ROCK PAGE 147 JUNE 34

21-6858-RS 2-47-GM

COOPERATIVE REFINERY ASS'N
 402 Schweiter Building
 Wichita 2, Kansas

Streck "B" #1
 NW NW SE Sec. 3-15S-15W
 Russell County, Kansas

Elevation 1818' D.F. (L&S)
 Date Commenced 9-24-47
 Date Completed 10-13-47

Rotary tools 0' to 3322' T.D.

Casing Record:
 8-5/8" casing cemented at 878'
 With 550 sacks cement.
 5-1/2" casing cemented at 3317'
 with 100 sacks cement

LOG

FORMATION TOPS - DF

0	60	Surface sand and sand
60	130	Shale and Red Bed
130	160	Sand
160	255	Shale and Shells
255	285	Sand
285	295	Sand, hard and sharp
295	315	Black Lime and Iron of Pyrite
315	385	Sand and Pyrite
385	450	Shale (sticky)
450	500	Shale
500	700	Red Bed and Shale
700	710	Sand
710	760	Red Bed
760	865	Red Bed and Shells
865	869	Shale and Red Bed
869	915	Anyhdrite
915	930	Red Bed
930	1070	Red Bed and Shale
1070	1265	Shale and Salt
1265	1510	Salt and Shells
1510	1580	Shale and Shells
1580	1680	Lime
1680	1805	Lime, Broken
1805	2040	Lime
2040	2120	Lime, Broken
2120	2395	Lime and Shale
2395	2545	Shale and Shells
2545	2735	Shale and Lime
2735	3015	Lime
3015	3058	Shale
3058	3287	Lime
3287	3303	Conglomerate and Chert
3303	3314	Chert and Arbuckle Lime
3314	3320	Conglomerate
3320	3324	Lime, Rotary Table
3324		Equals 3322 Derrick Floor

Top Heebner	2992'
Top Dodge	3009'
Top Lansing	3049'
Top Arbuckle	3317'

OCT 27 1947

PLUGGING
 FILE SEC. 3 T 15 R 15W
 BOOK PAGE 42 LINE 34 3+