


15.167.00008.00.00

WELL PLUGGING RECORD

Give All Information Completely
Make Required Affidavit
Mail or Deliver Report to:
Conservation Div.
State Corporation Commission
800 Bitting Building
Wichita, Kansas

NORTH

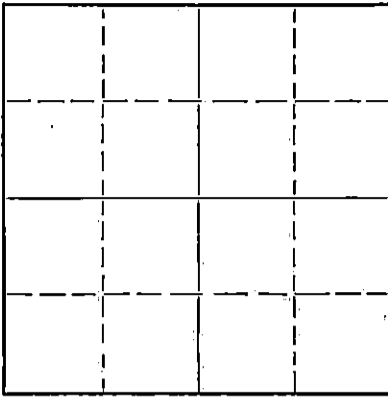

Locate well correctly on above
Section Plat.

Russell County, Sec. 14 Twp. 15S Rge. (E) 15 (W)
Location as "NE/CNW $\frac{1}{4}$ SW $\frac{1}{4}$ " or footage from lines NEc SE
Lease Owner Keystone Petroleum Co., Inc., et al
Lease Name M. E. Steinert Well No. 1
Office Address 814 Maple St., Russell, Kansas
Character of Well (completed as Oil, Gas or Dry Hole) Dry Hole
Date well completed 4-14- 1952
Application for plugging filed 19
Application for plugging approved 19
Plugging commenced 4-14- 1952
Plugging completed 4-14- 1952
Reason for abandonment of well or producing formation Dry Hole

If a producing well is abandoned, date of last production 19
Was permission obtained from the Conservation Division or its agents before plugging was commenced? Yes

Name of Conservation Agent who supervised plugging of this well C. D. Stough
Producing formation Depth to top Bottom Total Depth of Well Feet
Show depth and thickness of all water, oil and gas formations.

OIL, GAS OR WATER RECORDS


CASING RECORD

Formation	Content	From	To	Size	Put In	Pulled Out
				8 5/8"	211'	None

Describe in detail the manner in which the well was plugged, indicating where the mud fluid was placed and the method or methods used in introducing it into the hole. If cement or other plugs were used, state the character of same and depth placed, from feet to feet for each plug set.

Heavy mud from bottom to 3340' and ran 5 sax cement.
Mudded hole to 270', set 10' rock bridge and ran
10 sax cement. Mud hole to 40', ran 10 sax cement
on top.

4-2-48

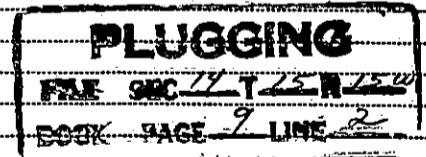

(If additional description is necessary, use BACK of this sheet)

Name of Plugging Contractor Brunson Drilling Co., Inc.
Address 333 1st Nat'l. Bank Bldg., Wichita, Kansas

STATE OF Kansas, COUNTY OF Sedgwick, ss.
Ralph B. McLaughlin (employee of owner) or (SUPERVISOR) of the above-described well,

being first duly sworn on oath, says: That I have knowledge of the facts, statements, and matters herein contained and the log of the above-described well as filed and that the same are true and correct. So help me God. BRUNSON DRILLING COMPANY, INC.

(Signature) Ralph B. McLaughlin
333 First Nat'l. Bank Bldg., Wichita, Kansas
(Address)

SUBSCRIBED AND SWORN to before me this 21st day of April, 1952, Kansas

Edwina C. Condit
Notary Public.

My commission expires September 23, 1953

KEYSTONE PETROLEUM CO., INC., et al
Wichita, Kansas

Well: M. E. Steinert #1

NEc SE Sec. 14-15S-15W
Russell County, Kansas

Commenced RD: 4-3-52
Completed RD: 4-14-52
Total Depth : 3381'

Elevation: 1866 D.F.
Initial Prod.
Contractor: Pam-Kar Drlg. Co.

Casing: 211' 8 5/8" O.D. 24# 8rd thd

STRATA	DEPTH		TOPS	
Surface soil & rock	25			
Sand & shale	130			
Sand	150			
Shale & shells	510			
Sand	625			
Shale & sand	750			
Redbeds & shale	902			
Chalk	910			
Anhydrite	945	Anhydrite	910	+958
Shale & shells	1180	Tarkio	2484	-616
Salt & shale	1375	Topeka	2808	-940
Shale & shells	1630	Heebner	3036	-1168
Broken lime	2100	Toronto	3053	-1185
Lime & shale	2130	Lansing	3097	-1229
Shale & lime	2340	Conglomerate	3315	-1447
Lime & shale	2425	Arbuckle	3339	-1471
Shale & lime	2483			
Shale & shells	2605			
Shale & lime	2720			
Lime & shale	3215			
Lime	3381			
Total Depth	3381			

I hereby certify that the above is a true and correct log of said well as reflected by the daily drilling reports.

BRUNSON DRILLING COMPANY, INC.
By

Ralph B. McLaughlin
Ralph B. McLaughlin, Sec.-Treas.

Signed and sworn to in my presence this 21st day of April, 1952,
by Ralph B. McLaughlin, Sec.-Treas. of the Brunson Drilling Company,
Inc., a corporation in the State of Kansas.

Edmund A. Combs
Notary Public.

My commission expires September 23, 1953.

