


Give All Information Completely
Make Required Affidavit
Mail or Deliver Report to:
Conservation Division
State Corporation Commission
800 Bittling Building
Wichita, Kansas

OR
FORMATION PLUGGING RECORD

Strike out upper line
when reporting plug-
ging of formations.

NORTH

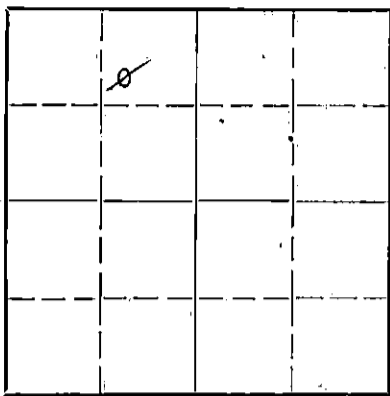

Locate well correctly on above
Section Plat

Russell County. Sec. 25 Twp. 15 Rge. 15 (E) (W)
Location as "NE $\frac{1}{4}$ NW $\frac{1}{4}$ SW $\frac{1}{4}$ " or footage from lines SW NE NW
Lease Owner Duwe & Farris et al
Lease Name DeWald Well No.
Office Address 709 Brown Building
Character of Well (completed as Oil, Gas or Dry Hole) Dry hole
Date well completed 12-30-43 19
Application for plugging filed 12-30-43 19
Application for plugging approved 12-30-43 19
Plugging commenced 12-30-43 19
Plugging completed 12-31-43 19
Reason for abandonment of well or producing formation Dry
If a producing well is abandoned, date of last production X 19
Was permission obtained from the Conservation Division or its agents before plugging was com-
menced? Yes

Name of Conservation Agent who supervised plugging of this well C. J. Alexander
Producing formation None Depth to top 3397 Bottom Total Depth of Well 3417 Feet
Show depth and thickness of all water, oil and gas formations.

OIL, GAS OR WATER RECORDS

CASING RECORD

Formation	Content	From	To	Size	Put In	Pulled Out
Soil & Sands	Water	260	285	8"	380'	None

Describe in detail the manner in which the well was plugged, indicating where the mud fluid was placed and the method or methods used in introducing it into the hold. If cement or other plugs were used, state the character of same and depth placed, from feet to feet for each plug set.

Hole filled with heavy mud from 3417' to 380' and a bridge set at 380' and cemented to 335' then ran heavy mud and set bridge to 26', then cemented to 6', then filled to surface with soil and mud top of hole cemented in surface pipe.

PLUGGING
FILE SEC 25-15-R154
BOOK PAGE 104 LINE 65

(If additional description is necessary, use BACK of this sheet)

Correspondence regarding this well should be addressed to Royer-Farris Drilling Co.
Address 709 Brown Building, Wichita, Kansas

STATE OF Kansas, COUNTY OF Sedgwick, ss.
L. A. Farris (employee of owner or (owner or operator) of the above-described well,
being first duly sworn on oath, says: That I have knowledge of the facts, statements and matters herein contained and the log of the above-described well as filed and that the same are true and correct. So help me God.

(Signature) [Signature]
709 Brown Building, Wichita, Kansas.
(Address)

SUBSCRIBED AND SWORN to before me this 19th day of January, 1944
Effie J. [Signature]
1-12-44
Notary Public.


My commission expires April 23, 1945.

DUWE-FARRIS DEWALD 1/4 SW-NE-NW Section 25-Township 15S
 Range 15W, Russell County, Kansas

Drilling Contractor: Royer-Farris Drilling Company
 Drilling Started: December 14, 1943
 Drilling Completed: December 30, 1943
 Elevation: 1897'
 380' 8-5/8 Surface Pipe
 Cemented Top to Bottom

Figures indicate bottom of formations.

Surface soil	0	10	Lime	2865	3045
Brown Clay	10	25	Lime & shale	3045	3100
Shale & shells	25	96	Lime	3100	3365
Lime	96	120	(Top of Dodge)	3105	
Shale, sand & shells	120	340	(Top of Lansing)	3128	
Shale & shells	340	480	Top of Conglomerate	3365	3397
Sand	480	580	Top of Arbuckle	3397	3417
Shale & shells	580	860	T.D.	3417	
Red Rock	860	910		No shows	D. & A.
Anhydrite	910	960			
Shale & shells	960	995			
Shale & red rock	995	1180			
Shale & shells	1180	1260			
Salt	1260	1405			
Shells & shale	1405	1690			
Lime	1690	1750			
Lime & shale	1750	1900			
Lime	1900	2065			
Broken lime & shale	2065	2220			
Lime	2220	2295			
Lime & shale	2295	2370			
Lime	2370	2390			
Shale & lime	2390	2520			
Shale & shells	2520	2590			
Lime	2590	2610			
Shale & lime	2610	2770			
Lime	2770	2790			
Shale & lime	2790	2865			

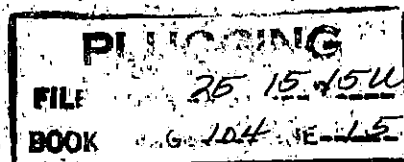

H. H. Royer does hereby swear that he is a partner of the firm, Royer-Farris Drilling Company, who were the drilling contractors on the above described well and that the above log is true and correct to the best of his knowledge and belief.

H. H. Royer

STATE OF KANSAS)

COUNTY OF SEDGWICK)

CS

BE IT REMEMBERED, That on this 16th day of March, A.D. 1944, before me, a Notary Public in and for said County and State, personally appeared H. H. Royer to me known to be the identical person described in and who executed the within and foregoing instrument and acknowledged to me that he executed the same as his free and voluntary act and deed for the uses and purposes therein set forth.

IN WITNESS WHEREOF, I have hereunto set my official signature and affixed my notarial seal, the day and year first above written.

My commission expires January 10, 1948.

Constance Lindahl
 Notary Public

