


WELL PLUGGING RECORD

Give All Information Completely
Make Required Affidavit
Mail or Deliver Report to:
Conservation Division
State Corporation Commission
211 No. Broadway
Wichita, Kansas

NORTH

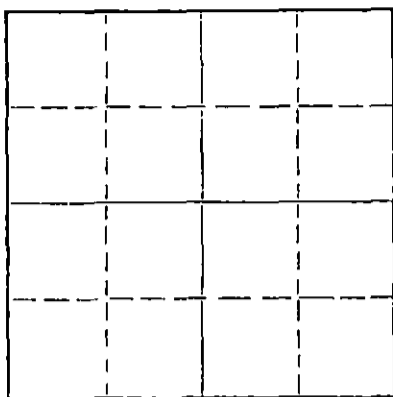

Locate well correctly on above
Section Plat

Russell County. Sec. 22 Twp. 15S Rge. (E) 15 (W)
Location as "NE/CNW/SW" or footage from lines 50' North of NW SE NE
Lease Owner Rains & Williamson Oil Co.
Lease Name KARST Well No. 1
Office Address 1425 Wichita Plaza, Wichita, Kansas
Character of Well (completed as Oil, Gas or Dry Hole) Dry Hole
Date well completed July 5 19 65
Application for plugging filed July 5 19 65
Application for plugging approved July 5 19 65
Plugging commenced July 5 19 65
Plugging completed July 5 19 65
Reason for abandonment of well or producing formation No oil or gas found
in commercial quantities.
If a producing well is abandoned, date of last production - - 19 -
Was permission obtained from the Conservation Division or its agents before plugging was commenced? Yes

Name of Conservation Agent who supervised plugging of this well Donald Truan, Russell, Kansas
Producing formation _____ Depth to top _____ Bottom _____ Total Depth of Well 3405 Feet
Show depth and thickness of all water, oil and gas formations.

OIL, GAS OR WATER RECORDS

CASING RECORD

FORMATION	CONTENT	FROM	TO	SIZE	PUT IN	PULLED OUT
				8-5/8"	313.45'	None

Describe in detail the manner in which the well was plugged, indicating where the mud fluid was placed and the method or methods used in introducing it into the hole. If cement or other plugs were used, state the character of same and depth placed, from _____ feet to _____ feet for each plug set.

Mud back to 305', set plug and 1/4 sack hulls, cemented through drill pipe with 25 sacks cement. Mud back to 40'. Set solid bridge with 1/2 sack hulls and plug. Capped with 10 sacks cement, 2 sacks in rathole. Plug down 3:15 p.m. 7-5-65.

7-14-65

RECEIVED
STATE CORPORATION COMMISSION

JUL 14 1965
CONSERVATION DIVISION
Wichita, Kansas

(If additional description is necessary, use BACK of this sheet)
Name of Plugging Contractor Rains & Williamson Oil Co.
Address 1425 Wichita Plaza, Wichita, Kansas

STATE OF KANSAS, COUNTY OF SEDGWICK, ss.
Wilson Rains (employee or owner) or (owner or operator) of the above-described well, being first duly sworn on oath, says: That I have knowledge of the facts, statements, and matters herein contained and the log of the above-described well as filed and that the same are true and correct. So help me God.

(Signature) Wilson Rains
Wilson Rains
1425 Wichita Plaza, Wichita, Kansas
(Address)

SUBSCRIBED AND SWORN TO before me this 8th day of July, 19 65

My commission expires January 8, 1968

Shirley Keck
Shirley Keck Notary Public.

15. 167.30056.00.00

ROTARY DRILLING LOG

OPERATOR: Rains & Williamson Oil Co. #1 KARST
50' North of NW SE NE
Section 22-15S-15W
Russell County, Kansas

CONTRACTOR: Rains & Williamson Oil Co.
COMMENCED: 6-28-65
COMPLETED: 7-5-65
REMARKS: Ran 313.45' of 8-5/8" surface casing with 200 sacks GL3 cement.

FORMATION;

Post Rock & Clay	35'
Shale & Sand	314'
Shale & Red Bed	455'
Sand 535	535'
Red Bed & Shale	928'
Anhydrite	959'
Shale	1195'
Shale & Lime Streaks	1705'
Lime & Shale	2492'
Shale & Lime Shells	2825'
Lime & Shale	2915'
Lime	3035'
Lime & Shale	3131'
Lime	3405'
Rotary Total Depth (D&A)	3405'

RECEIVED
STATE CORPORATION COMMISSION

JUL 14 1965

CONSERVATION DIVISION
Wichita, Kansas


We certify the above log is true and correct to the best of our knowledge and belief.

RAINS & WILLIAMSON OIL CO.


Wilson Rains, Partner

Subscribed and sworn to before me, a Notary Public in and for the State of Kansas, County of Sedgwick, this 8th day of July, 1965.

My Commission Expires:
January 8, 1968

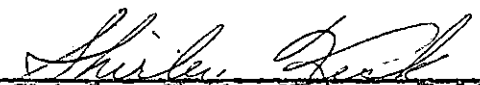
Shirley Keck, Notary Public