


STATE OF KANSAS
STATE CORPORATION COMMISSION

WELL PLUGGING RECORD

Give All Information Completely
Make Required Affidavit
Mail or Deliver Report to
Conservation Division
State Corporation Comm.
245 North Water
Wichita, KS 67202

Reno County, Sec. 27 Twp. 24S Rge. 8W ~~N/W~~
Location as "NE/CNW $\frac{1}{2}$ SW $\frac{1}{2}$ " or footage from lines
S/2 SE/4 NW/4

Lease Owner L. G. Stephenson & Co., Inc.
Lease Name Ginn Well No. 1
Office Address 770 E. Kellogg, Suite 670, Wichita, Ks. 6702
Character of Well (Completed as Oil, Gas or Dry Hole)

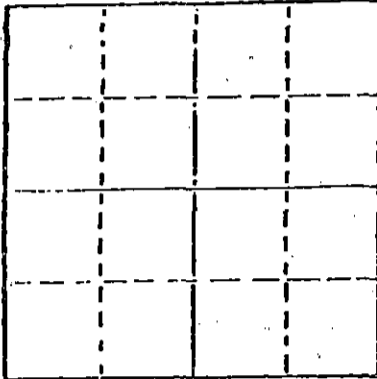

Locate well correctly on above
Section Plat

D & A
Date Well completed July 15, 1979
Application for plugging filed July 15, 1979
Application for plugging approved July 15, 1979
Plugging commenced July 16, 1979
Plugging completed July 16, 1979
Reason for abandonment of well or producing formation
D & A

If a producing well is abandoned, date of last production
19

Was permission obtained from the Conservation Division or
its agents before plugging was commenced? Yes

Name of Conservation Agent who supervised plugging of this well Gilbert Toman
Producing formation Depth to top Bottom Total Depth of Well 3,750'
Show depth and thickness of all water, oil and gas formations.

OIL, GAS OR WATER RECORDS

CASING RECORD

FORMATION	CONTENT	FROM	TO	SIZE	PUT IN	PULLED OUT
				8 5/8"	284.46'	-0-

Describe in detail the manner in which the well was plugged, indicating where the mud fluid
was placed and the method or methods used in introducing it into the hold. If cement or other
plugs were used, state the character of same and depth placed, from feet to
feet for each plug set.

Mud to 292' & 40 sx cement
Mud to 40' & 1/2 sx hulls, plug & 10 sx cement
5 sx cement in rathole

RECEIVED
STATE CORPORATION COMMISSION

JUL 25 1979

CONSERVATION DIVISION
Wichita, Kansas

7-25-79

(If additional description is necessary, use BACK of this sheet)

Name of Plugging Contractor Red Tiger Drilling Company
1720 KSB&T Building, Wichita, Kansas 67202

STATE OF Kansas COUNTY OF Sedgwick, ss. contractor
Gloria Fawcett (employee of ~~XXXXXXXXXXXXXXXXXXXXXXXXXXXX~~)


of the above-described well, being first duly sworn on oath, says: That I have knowledge of
the facts, statements, and matters herein contained and the log of the above-described well
as filed and that the same are true and correct. So help me God.

(Signature) Gloria Fawcett
1720 KSB&T Building, Wichita, Kansas 67202
(Address)

SUBSCRIBED AND SWORN TO before me this 20th day of July, 1979.

Jimmie L. Farrice
Notary Public.

My commission expires 10-15-80

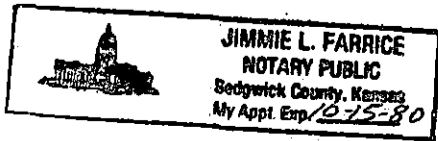

DRILLERS LOG

No. 1 Ginn

CASING RECORD:	COMPANY:	L. G. Stephenson & Co., Inc.	DESCRIPTION:
8 5/8" @ 292.86'	CONTRACTOR:	Red Tiger Drilling Company	S/2 SE/4 NW/4
w/175 sx cement	COMMENCED:	July 7, 1979	Sec. 27-T24S-R8W
	COMPLETED:	July 16, 1979	Reno County, Kansas
TOTAL DEPTH: 3,750'			ELEVATION: 1,648' KB

<u>FORMATION</u>	<u>FROM</u>	<u>TO</u>	<u>REMARKS</u>
Shale & Red Bed	0	300	
Shale	300	1410	
Lime & Shale	1410	3185	
Lime	3185	3735	
Cherty Lime	3735	3750	
RTD		3750	

I certify that this is a true and correct copy of the above log to the best of my knowledge.

RED TIGER DRILLING COMPANY

Gloria Fawcett
Gloria Fawcett

Subscribed and sworn to before me this 20th day of July, 1979.



Jimmie L. Farrice
Notary Public

RECEIVED
STATE CORPORATION COMMISSION
JUL 25 1979
CONSERVATION DIVISION
Wichita, Kansas