


STATE OF KANSAS  
STATE CORPORATION COMMISSION

WELL PLUGGING RECORD

Give All Information Completely  
Make Required Affidavit  
Mail or Deliver Report to  
Conservation Division  
State Corporation Comm.,  
245 North Water  
Wichita, KS 67202

Ford County, Sec. 9 Twp. 25S Rge. 22 NE/W  
Location as "NE/CNW $\frac{1}{4}$ SW $\frac{1}{4}$ " or footage from lines 150' W of C NE SE  
Lease Owner Murfin Drilling Co.  
Lease Name Grissette Well No. 1  
Office Address 617 Union Center, Wichita, Ks. 67202  
Character of Well (Completed as Oil, Gas or Dry Hole) dry hole

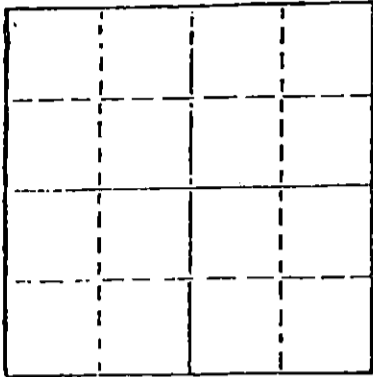

Locate well correctly on above Section Plat

Date Well completed 7-30-1978  
Application for plugging filed 7-30-1978  
Application for plugging approved 7-30-1978  
Plugging commenced 7-30-1978  
Plugging completed 7-30-1978

Reason for abandonment of well or producing formation no commercial quantities of oil or gas encountered  
If a producing well is abandoned, date of last production -- 19

Was permission obtained from the Conservation Division or its agents before plugging was commenced? yes

Name of Conservation Agent who supervised plugging of this well Bill Owen  
Producing formation \_\_\_\_\_ Depth to top \_\_\_\_\_ Bottom \_\_\_\_\_ Total Depth of Well 4805  
Show depth and thickness of all water, oil and gas formations.

OIL, GAS OR WATER RECORDS

CASING RECORD

FORMATION	CONTENT	FROM	TO	SIZE	PUT IN	PULLED OUT
surface hole	shale	surf	524'	8-5/8"	517	none

Describe in detail the manner in which the well was plugged, indicating where the mud fluid was placed and the method or methods used in introducing it into the hold. If cement or other plugs were used, state the character of same and depth placed, from \_\_\_\_\_ feet to \_\_\_\_\_ feet for each plug set.

Fluid to 520', plug, 50 sx  
Fluid to 40', plug, 12 sx  
3 sx in rat hole

RECEIVED  
STATE CORPORATION COMMISSION  
8-8-1978  
AUG 08 1978

CONSERVATION DIVISION  
Wichita, Kansas

(If additional description is necessary, use BACK of this sheet)

Name of Plugging Contractor \_\_\_\_\_

STATE OF Kansas COUNTY OF Sedgwick, ss.  
Ella Priess (employee of owner) or (owner or operator)  
of the above-described well, being first duly sworn on oath, says: That I have knowledge of the facts, statements, and matters herein contained and the log of the above-described well as filed and that the same are true and correct. So help me God.

(Signature) Ella Priess  
Suite 515, R.H. Garvey Bldg., Wichita, Ks. 6720  
(Address)

SUBSCRIBED AND SWORN TO before me this 1st day of August, 19 78

My commission expires 4/30/79  
Dorothy L. Schmidt Notary Public.

DOROTHY L. SCHMIDT  
STATE NOTARY PUBLIC  
Sedgwick County, Kansas  
My Appt. Exp. April 30, 1979

DRILLER'S LOG

MURFIN DRILLING COMPANY  
No. 1 Grissette  
150' W of C. NE SE  
Sec. 9-25S-22W  
Ford County, Kansas

Commenced: 7-19-78  
Completed: 7-30-78

Surface Casing: 518' of 8-5/8"  
cemented w/325 sx common, 2% gel,  
3% cc. 7-19-78

RECEIVED  
STATE CORPORATION COMMISSION

AUG 08 1978

CONSERVATION DIVISION  
Wichita, Kansas

<u>FORMATION</u>	<u>DEPTH</u>
Surface Hole	0 - 524
Shale & Sand	524 - 1730
Shale	1730 - 2175
Shale & Lime	2175 - 2400
Lime & Shale	2400 - 3600
Lime	3600 - 4805 RTD

I do hereby certify that the foregoing statements are true and correct to the best of my knowledge and belief.

D. N. B. DRILLING, INC.

*Ella Priess*

Ella Priess

STATE OF KANSAS: ss:

Subscribed and sworn to before me this 1st day of August, 1978.

*Dorothy L. Schmidt*

Dorothy L. Schmidt, Notary Public

DOROTHY L. SCHMIDT  
STATE NOTARY PUBLIC  
Sedgwick County, Kansas  
My Appt. Exp. April 30, 1979