

15-057-20095-0000


STATE OF KANSAS
STATE CORPORATION COMMISSION

WELL PLUGGING RECORD

Give All Information Completely
Make Required Affidavit
Mail or Deliver Report to
Conservation Division
State Corporation Comm.
245 North Water
Wichita, KS 67202

Ford County, Sec. 10 Twp. 25S Rge. 22W EXX
Location as "NE/CNW $\frac{1}{4}$ /SW $\frac{1}{4}$ " or footage from lines
SE NW

Lease Owner E. L. Brooks
Lease Name Kyle Well No. 1
Office Address 915 United Founders Tower, Okla. City, Okla.
Character of Well (Completed as Oil, Gas or Dry Hole) Dry Hole

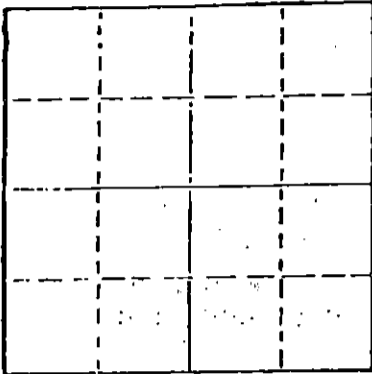

Locate well correctly on above Section Plat

Date Well completed January 11, 1977
Application for plugging filed Verbal Application 1977
Application for plugging approved Verbal Approval 1977
Plugging commenced January 11, 1977
Plugging completed January 11, 1977
Reason for abandonment of well or producing formation

If a producing well is abandoned, date of last production 19

Was permission obtained from the Conservation Division or its agents before plugging was commenced? Yes

Name of Conservation Agent who supervised plugging of this well Clarence Thomas, Jr.
Producing formation Depth to top Bottom Total Depth of Well 4,854'
Show depth and thickness of all water, oil and gas formations.

OIL, GAS OR WATER RECORDS CASING RECORD

FORMATION	CONTENT	FROM	TO	SIZE	PUT IN	PULLED OUT
				8-5/8"	505'	None

Describe in detail the manner in which the well was plugged, indicating where the mud fluid was placed and the method or methods used in introducing it into the hold. If cement or other plugs were used, state the character of same and depth placed, from feet to feet for each plug set.


Filled hole with heavy rotary mud from 4,854 ft. (rotary total depth) to 500 ft. Set plug at 500 ft. and cemented with 50 sacks cement.
Filled hole with heavy rotary mud from 500 ft. to 40 ft. Set solid plug at 40 ft. and cemented to cellar with 15 sacks cement, 5 sacks cement in rat hole.

Plugging operations accomplished utilizing Halliburton Oil Well cementing pump truck through 4-1/2 inch drill pipe.

(If additional description is necessary, use BACK of this sheet)

Name of Plugging Contractor Halliburton Services
410 Union Center Building, Wichita, Kansas 67202

STATE OF Kansas COUNTY OF Sedgwick ss.
I, Dean Britting, Agent of the above-described well, being first duly sworn on oath, says: That I have knowledge of the facts, statements, and matters herein contained and the log of the above-described well as filed and that the same are true and correct. So help me God.

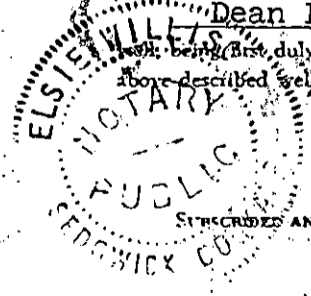

(Signature) *Dean Britting*
200 No. Main, Wichita, Kansas 67202 (Address)

Subscribed and sworn to before me this 31st day of January 1977

My commission expires June 30, 1978

Elsie Willison
Elsie Willison - Notary Public.

RECEIVED
STATE CORPORATION COMMISSION
FEB 04 1977
CONSERVATION DIVISION
Wichita, Kansas

2-4-77

KANSAS GEOLOGICAL SOCIETY API NO. - 15-057-20,095-0000
 KANSAS WELL LOG BUREAU - KANSAS WELL SAMPLE BUREAU
 KANSAS GEOLOGICAL SOCIETY BUILDING
 508 EAST MURDOCK - WICHITA, KANSAS


COMPANY E. L. Brooks

SEC. 10 T. 25S R. 22W
 LOC. SE NW

FARM Kyle NO. 1

COUNTY Ford

TOTAL DEPTH 4,854'
 COMM. December 28, 1976 COMP. January 11, 1977
 SHOT OR TREATED
 CONTRACTOR H-30, Inc.
 ISSUED January 31, 1977

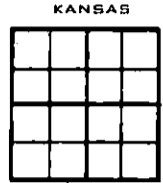

CASING
 20 10
 15 8 -5/8" 505' cemented w/325 sxs cement ELEVATION 2,414 KB
 12 6
 13 5

PRODUCTION

	FIGURES INDICATE BOTTOM OF FORMATIONS
Shale	506'
Sand and Shale	1,424'
Shale	1,523'
Anhydrite	1,540'
Shale	2,500'
Shale and Lime	3,420'
Lime and Shale	3,747'
Lime	4,854'
Rotary Total Depth	4,854'

STATE OF KANSAS
 COMMISSIONER OF GEOLOGY
 FEB 04 1977
 GEOLOGY DIVISION
 WICHITA, KANSAS

I hereby certify the above and foregoing
 to be a true and correct log of the above
 described well as shown by the drilling
 reports.

H-30, INC.

Dean Britting
 Dean Britting

State of Kansas }
 County of Sedgwick } ss:

Subscribed and Sworn to before me a Notary
 Public in and for said county and state
 this 31st. day of January, 1977.

Elsie Willison
 Elsie Willison - Notary Public

My Commission Expires:
 June 30, 1978

