


WELL PLUGGING RECORD

Give All Information Completely
Make Required Affidavit
Mail or Deliver Report to:
Conservation Division
State Corporation Commission
212 No. Market
Wichita, Kansas

NORTH

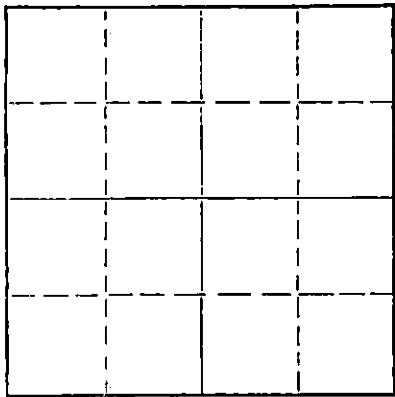

Locate well correctly on above
Section Plat

Kingman County, Sec. 9 Twp. 30S Rge. (E) 9 (W)
Location as "NE/CNW/SW" or footage from lines C E/2 NW/4
Lease Owner Sierra Petroleum Company
Lease Name Whitmer Well No. B-1
Office Address 211 N. Broadway, Wichita, Kansas 67202
Character of Well (completed as Oil, Gas or Dry Hole) Dry Hole
Date well completed May 20 19 69
Application for plugging filed May 20 19 69
Application for plugging approved May 20 19 69
Plugging commenced May 20 19 69
Plugging completed May 20 19 69
Reason for abandonment of well or producing formation Dry Hole

If a producing well is abandoned, date of last production 19
Was permission obtained from the Conservation Division or its agents before plugging was commenced? Yes

Name of Conservation Agent who supervised plugging of this well Ralph Warren
Producing formation Depth to top Bottom Total Depth of Well Feet
Show depth and thickness of all water, oil and gas formations.

OIL, GAS OR WATER RECORDS

CASING RECORD

FORMATION	CONTENT	FROM	TO	SIZE	PUT IN	PULLED OUT
Sand, Shale & Shells		0	250	8-5/8"	250'	None

Describe in detail the manner in which the well was plugged, indicating where the mud fluid was placed and the method or methods used in introducing it into the hole. If cement or other plugs were used, state the character of same and depth placed, from feet to feet for each plug set.

Filled hole with heavy mud; placed plug at 240 feet with 1/2 sack hulls on top, spotted 25 sacks cement on top of plug and hulls. Filled hole with heavy mud to 40 feet; spotted 15 sacks cement on top of plug and 1/2 sack hulls. Spotted 2 sacks cement in rat hole.

RECEIVED
STATE CORPORATION COMMISSION
MAY 26 1969
CONSERVATION DIVISION
Wichita, Kansas
5-26-69

(If additional description is necessary, use BACK of this sheet)
Name of Plugging Contractor H-30, INC.
Address 200 N. Main, Wichita, Kansas 67202

STATE OF KANSAS COUNTY OF SEDGWICK, ss.
Richard G. Smith (employee of owner) or (owner or operator) of the above-described well, being first duly sworn on oath, says: That I have knowledge of the facts, statements, and matters herein contained and the log of the above-described well as filed and that the same are true and correct. So help me God.

(Signature) Richard G. Smith
200 N. Main, Wichita, Kansas 67202
(Address)

SUBSCRIBED AND SWORN to before me this 23 day of May, 19 69

My commission expires April 21, 1971
Martha Hartpence Notary Public.

KANSAS GEOLOGICAL SOCIETY
KANSAS WELL LOG BUREAU - KANSAS WELL SAMPLE BUREAU
KANSAS GEOLOGICAL SOCIETY BUILDING
508 EAST MURDOCK - WICHITA, KANSAS

COMPANY Sierra Petroleum Company
FARM Whitmer No. B-1


SEC. 9 T. 30S R. 9W
LOC. C E/2 NW/4

COUNTY Kingman

TOTAL DEPTH 4,351
COMM. May 9, 1969
SHOT OR TREATED
CONTRACTOR H-30, INC.
ISSUED

COMP. May 20, 1969

RECEIVED
STATE CORPORATION COMMISSION
MAY 26 1969
CONSERVATION DIVISION
Wichita, Kansas

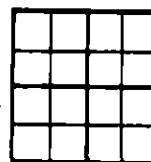

CASING

20 10
15 8-5/8" @ 250 w/225 sacks cement
12 6
13 5

ELEVATION 1693 DF
1696 KB
PRODUCTION D & A

FIGURES INDICATE BOTTOM OF FORMATIONS

ELECTRICAL LOG TOPS

Sand, Shale & Shells	250	Indian Cave	2454
Shale & Redrock	350	Howard	2896
Shale & Shells	1462	Topeka	3009
Shale & Lime	1728	Heebner	3412
Lime	1795	Lansing	3630
Shale & Lime	2000	Base K. C.	4110
Lime & Shale	2155	Cherokee	4248
Sandy Shale & Lime Streaks	2500	Mississippi	4290
Lime & Shale	2675	LTD	4355
Shale & Lime	3005		
Lime & Shale	3523		
Sandy Shale	3619		
Lime	4351		
Rotary Total Depth	4351		

I hereby certify the above and foregoing to be a true and correct log of the above described well as shown by the drilling reports.

H-30, INC.

Richard G. Smith
Richard G. Smith

STATE OF KANSAS }
COUNTY OF SEDGWICK } SS:

Subscribed and Sworn to before me a Notary Public in and for said county and state this 23rd day of May, 1969.

Martha Hartpence
Martha Hartpence - Notary Public

My Commission Expires:

April 21, 1971