


Give All Information Completely  
Make Required Affidavit  
Mail or Deliver Report to:  
Conservation Division  
State Corporation Commission  
212 North Market, Insurance Bldg.  
Wichita, Kansas

WELL PLUGGING RECORD

Hamilton County, Sec. 7 Twp. 22S Rge. 40 (W)  
Location as "NE/CNW/SW" or footage from lines C NE SW  
Lease Owner LVO CORPORATION  
Lease Name 0720 Well No. 1  
Office Address P. O. Box 2848, Tulsa, Oklahoma 74101  
Character of Well (completed as Oil, Gas or Dry Hole) Gas  
Date well completed December 7 1964  
Application for plugging filed September 7 1971  
Application for plugging approved 19  
Plugging commenced September 13 1971  
Plugging completed September 14 1971  
Reason for abandonment of well or producing formation Depleted

NORTH

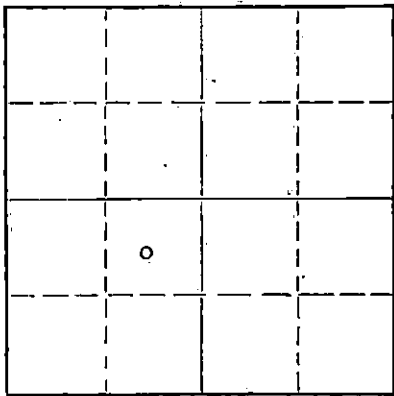

Locate well correctly on above Section Plat

If a producing well is abandoned, date of last production 19  
Was permission obtained from the Conservation Division or its agents before plugging was commenced? Yes

Name of Conservation Agent who supervised plugging of this well  
Producing formation \_\_\_\_\_ Depth to top \_\_\_\_\_ Bottom \_\_\_\_\_ Total Depth of Well \_\_\_\_\_ Feet  
Show depth and thickness of all water, oil and gas formations.

OIL, GAS OR WATER RECORDS

CASING RECORD

FORMATION	CONTENT	FRDM	TO	SIZE	PUT IN	PULLED OUT
				8-5/8"	312'	
				4-1/2"	2,750'	2,167'

Describe in detail the manner in which the well was plugged, indicating where the mud fluid was placed and the method or methods used in introducing it into the hole. If cement or other plugs were used, state the character of same and depth placed, from \_\_\_\_\_ feet to \_\_\_\_\_ feet for each plug set.

Mixed 20 sxs plug with top @ 2506'.  
Mixed 40 sxs plug 350' to 250'.  
15 sx plug @ 45' to 0'.

RECEIVED  
STATE CORPORATION COMMISSION  
SEP 15 1971  
CONSERVATION DIVISION  
Wichita, Kansas

(If additional description is necessary, use BACK of this sheet)  
Name of Plugging Contractor Sargents Casing Pulling Service  
Address P. O. Box 506, Liberal, Kansas 67901

STATE OF OKLAHOMA, COUNTY OF TULSA, ss.  
J. N. Sanford, Drilling Engineer (employee of owner) or (owner or operator) of the above-described well, being first duly sworn on oath, says: That I have knowledge of the facts, statements, and matters herein contained and the log of the above-described well as filed and that the same are true and correct. So help me God.

(Signature) *J. N. Sanford*  
P. O. Box 2848, Tulsa, Oklahoma 74101  
(Address)

SUBSCRIBED AND SWORN to before me this 14th day of September, 1971

*Margaret Heath*  
Notary Public.

My commission expires 8-10-73

15-075-30013-0000

RECEIVED  
STATE CORPORATION COMMISSION

SEP 9 1971

CONSERVATION DIVISION  
Wichita, Kansas

Unit 720

<u>From</u>	<u>To</u>	<u>Formation</u>
0	312	Blue shale
312	1126	shells & shale
1126	1350	
1350	2304	Anhyd & sl.
2304	2750 TD	Dol & sd.