


Give All Information Completely
Make Required Affidavit
Mail or Deliver Report to:
Conservation Division
State Corporation Commission
212 North Market, Insurance Bldg.
Wichita, Kansas

WELL PLUGGING RECORD

NORTH

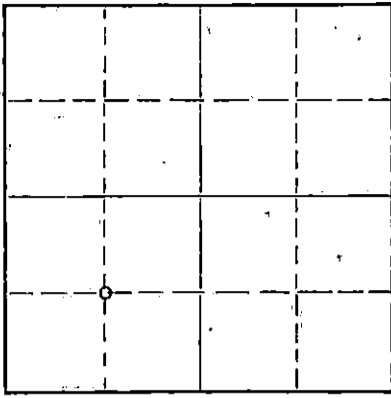

Locate well correctly on above
Section Plat

Hamilton County. Sec. 16 Twp. 22S Rge. (E) 40 (W)
Location as "NE/CNWxSWx" or footage from lines C, SW/4
Lease Owner LVO CORPORATION
Lease Name Unit 1620 Well No. 1
Office Address P. O. Box 2848, Tulsa, Oklahoma 74101
Character of Well (completed as Oil, Gas or Dry Hole) Gas
Date well completed June 22 19 61
Application for plugging filed July 22 19 74
Application for plugging approved August 2 19 74
Plugging commenced October 30 19 74
Plugging completed October 31 19 74
Reason for abandonment of well or producing formation depleted

If a producing well is abandoned, date of last production January 17 19 74
Was permission obtained from the Conservation Division or its agents before plugging was commenced? Yes

Name of Conservation Agent who supervised plugging of this well _____
Producing formation Winfield Depth to top 2706 Bottom 2711 Total Depth of Well 2722 Feet
Show depth and thickness of all water, oil and gas formations.

OIL, GAS OR WATER RECORDS

CASING RECORD

FORMATION	CONTENT	FROM	TO	SIZE	PUT IN	PULLED OUT
				4 1/2	2704	0

Describe in detail the manner in which the well was plugged, indicating where the mud fluid was placed and the method or methods used in introducing it into the hole. If cement or other plugs were used, state the character of same and depth placed, from _____ feet to _____ feet for each plug set.

Pumped 25 sack plug with top at 2450 feet.
35 sack plug at 400 to 0 feet.

RECEIVED
STATE CORPORATION COMMISSION

NOV 27 1974

CONSERVATION DIVISION
Wichita, Kansas

(If additional description is necessary, use BACK of this sheet)
Name of Plugging Contractor Sargent's Casing Pulling Service
Address Box 506, Liberal, Kansas

STATE OF OKLAHOMA COUNTY OF TULSA, ss.
Kenneth A. Weikel (employee of owner) or (owner/operator) of the above-described well, being first duly sworn on oath, says: That I have knowledge of the facts, statements, and matters herein contained and the log of the above-described well as filed and that the same are true and correct. So help me God.

(Signature) *Kenneth A. Weikel*
Production Engineer, Tulsa Division
P. O. Box 2848, Tulsa, Oklahoma 74101
(Address)

SUBSCRIBED AND SWORN to before me this 22nd day of November, 19 74

My commission expires January 23, 1977

Mary E. Russell
Notary Public.



LEASE: LARRY DIKEMAN #1-16
OPERATOR: HAMILTON BROTHERS
CONTRACTOR: EARL P. WAKEFIELD
COMM: 6-13-61 COMP: 6-22-61

LOCATION: C SW/4
SECTION 16-22N-40W
HAMILTON COUNTY, KANSAS
CASING: 4 1/2" Set at 2704'

Clay, Sand & Blue Shale	480
Sand & Gravel	637
Gray Shale & Sand	945
Shale, Sandy Lime & Anhydrite	1335
Lime, Shale, Anhydrite & Red Bed	1500
Shale, Lime Streaks	1925
Shale & Sand	2251
Lime & Shale	2536
Red Shale & Anhydrite	2659
Lime & Shale	2722
T. D.	2722

RECEIVED
STATE CORPORATION COMMISSION
AUG 2 1974
CONSERVATION DIVISION
Wichita, Kansas

STATE OF KANSAS)
COUNTY OF SEDGWICK)

ss

I HEREBY CERTIFY THAT THE ABOVE IS A TRUE AND CORRECT COPY
OF THE LOG ON THE LARRY DIKEMAN #1-16 WELL, LOCATED C SW/4 OF SECTION
16-22N-40W, HAMILTON COUNTY, KANSAS.

EARL P. WAKEFIELD

By Fred S. Butler

Subscribed and sworn before me this 30th day of June, 1961



Wanda W. Riley
MANDA W. RILEY NOTARY PUBLIC

My commission expires January 25, 1965