

STATE OF KANSAS  
STATE CORPORATION COMMISSION

WELL PLUGGING RECORD

Give All Information Completely  
Make Required Affidavit  
Mail or Deliver Report to  
Conservation Division  
State Corporation Comm.  
245 North Water  
Wichita, KS 67202

Hamilton County, Sec. 10 Twp. 22 Rge. 41 E/W  
Location as "NE/CNW $\frac{1}{4}$ /SW $\frac{1}{4}$ " or footage from lines  
SE NW


Lease Owner Midwest Casing Pulling  
Lease Name HCU 1021 Well No. 1021  
Office Address Box F, Sublette, Kansas 67877  
Character of Well (Completed as Oil, Gas or Dry Hole) Gas

Date Well completed 9-11 1964  
Application for plugging filed 4-30 1979  
Application for plugging approved 5-1 1979  
Plugging commenced 6-4 1979  
Plugging completed 6-7 1979

Reason for abandonment of well or producing formation Lost hole  
If a producing well is abandoned, date of last production 19

Was permission obtained from the Conservation Division or its agents before plugging was commenced? Yes

Name of Conservation Agent who supervised plugging of this well Mr. Thomas  
Producing formation Winfield Depth to top 2760' Bottom 2778' Total Depth of Well 2769'  
Show depth and thickness of all water, oil and gas formations.

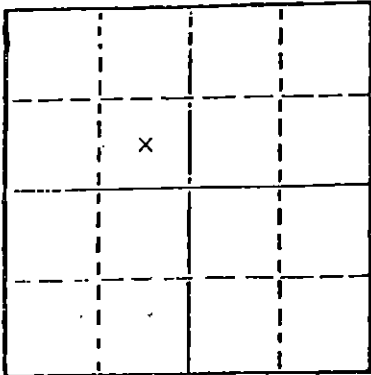

Locate well correctly on above Section Plat

OIL, GAS OR WATER RECORDS

CASING RECORD

FORMATION	CONTENT	FROM	TO	SIZE	PUT IN	PULLED OUT
Surface				7"	264'	0'
Production				4 1/2"	2766'	2024'

Describe in detail the manner in which the well was plugged, indicating where the mud fluid was placed and the method or methods used in introducing it into the hold. If cement or other plugs were used, state the character of same and depth placed, from \_\_\_\_\_ feet to \_\_\_\_\_ feet for each plug set.

Sanded up bottom to 2300'  
Displaced 2300' to 310'  
Spotted 25 sacks cement 310' to 210'  
Displaced 210' to 40'  
Put bridge & 10 sacks cement 40' to 0'  
Cut off 7" 3' below ground level.

(If additional description is necessary, use BACK of this sheet)

Name of Plugging Contractor Midwest Casing Pulling  
Box F, Sublette, Kansas 67877 Permit # 776

STATE OF KANSAS COUNTY OF HASKELL, ss.  
I Edgar J. Eves (employee of owner) or (owner or operator)  
of the above-described well, being first duly sworn on oath, says: That I have knowledge of the facts, statements, and matters herein contained and the log of the above-described well as filed and that the same are true and correct. So help me God.

(Signature) Edgar J. Eves  
Box F, Sublette, Kansas 67877  
(Address)

SUBSCRIBED AND SWORN TO before me this 8th day of June, 1979

Sondra L. Eves  
Notary Public.

My commission expires 12-6-80



RECEIVED  
STATE CORPORATION COMMISSION

JUL 11 1979

CONSERVATION DIVISION  
Wichita, Kansas