
FORM CP-4

15-075-10027-0000

STATE OF KANSAS
STATE CORPORATION COMMISSION

WELL PLUGGING RECORD

Give All Information Completely
Make Required Affidavit
Mail or Deliver Report to
Conservation Division
State Corporation Comm.
245 North Water
Wichita, KS 67202

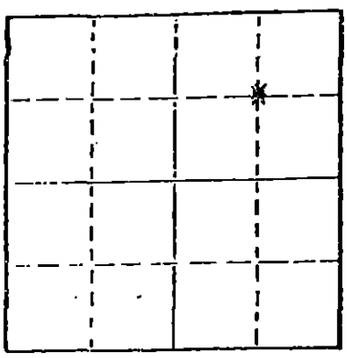

Locate well correctly on above Section Plat

Hamilton County. Sec. 19 Twp. 22 Rge. 41 E/W
Location as "NE/CNW¼SW¼" or footage from lines
C NE 1/4
Lease Owner Midwest Casing Pulling
Lease Name HCU Well No. 1921
Office Address Box F, Sublette, Kansas 67877
Character of Well (Completed as Oil, Gas or Dry Hole)
Gas
Date Well completed 7-17 1963
Application for plugging filed 4-30 1979
Application for plugging approved 5-1 1979
Plugging commenced 6-20 1979
Plugging completed 6-22 1979
Reason for abandonment of well or producing formation
Lost Hole
If a producing well is abandoned, date of last production
19
Was permission obtained from the Conservation Division or its agents before plugging was commenced? Yes

Name of Conservation Agent who supervised plugging of this well Mr. Thomas
Producing formation Winfield Depth to top 2650' Bottom 2668' Total Depth of Well 2680'
Show depth and thickness of all water, oil and gas formations.

OIL, GAS OR WATER RECORDS — CASING RECORD

FORMATION	CONTENT	FROM	TO	SIZE	PUT IN	PULLED OUT
Surface				8 5/8"	to 108'	0'
Production				4 1/2"	2680'	2022'

Describe in detail the manner in which the well was plugged, indicating where the mud fluid was placed and the method or methods used in introducing it into the hold. If cement or other plugs were used, state the character of same and depth placed, from feet to feet for each plug set.

Sanded bottom to 2450'
Displaced 2450' to 160'
Pumped 35 sacks cement 160' to 60'
Put bridge 40' to 0'
Cut off 8 5/8" 3' below ground level

7-11-79

RECEIVED
STATE CORPORATION COMMISSION
JUL 11 1979
CONSERVATION DIVISION
Wichita, Kansas

(If additional description is necessary, use BACK of this sheet)
Name of Plugging Contractor Midwest Casing Pulling
Box F, Sublette, Kansas Permit # 776

STATE OF KANSAS COUNTY OF HASKELL, ss.
I Edgar J. Eves (employee of owner) or (owner or operator)
of the above-described well, being first duly sworn on oath, says: That I have knowledge of the facts, statements, and matters herein contained and the log of the above-described well as filed and that the same are true and correct. So help me God.

(Signature) Edgar J. Eves
Box F, Sublette, Kansas 67877
(Address)

SUBSCRIBED AND SWORN TO before me this 23rd day of June, 1979

Sondra L Eves
Notary Public.

My commission expires 12-6-80

SONDRA L. EVES
Haskell County, Ks.
My Appt. Exp. 12-6-80