

STATE OF KANSAS
STATE CORPORATION COMMISSION
200 Colorado Derby Bldg.
Wichita, Kansas 67202

Form CP-4
Rev. 12-15-80
STATE CORPORATION COMMISSION

AUG 10 1981

WELL PLUGGING RECORD

Give All Information Completely
Make Required Affidavit

8-10-81
CONSERVATION DIVISION
Wichita, Kansas

COUNTY Hamilton SEC. 17 TWP. 22 RGE. 41W E/W
Location as in quarters or footage from lines:
G NW SE

Lease Owner Ladd Petroleum Corporation
Lease Name HCV 1721 Well No. 1
Office Address Liberal, Kansas 67901
Character of Well (Completed as Oil, Gas or Dry Hole): Dry Hole
Date Well Completed 12-6-63
Application for plugging filed 5-4-81
Plugging commenced 5-28-81
Plugging completed 6-3-81
Reason for abandonment of well or producing formation _____

Locate Well
correctly on above
Section Platt.

Was permission obtained from the Conservation Division or it's
Agent's before plugging was commenced? Yes

Name of Conservation Agent who supervised plugging of this well Clarence Thomas

Producing formation _____ Depth to top _____ bottom _____ T.D. 2715

Show depth and thickness of all water, oil and gas formations.

OIL, GAS OR WATER RECORDS

Casing Record

Formation	Content	From	To	Size	Put in	Pulled Out
				8 5/8	136	none
				4 1/2	2715	1010
				1 1/4	2686	2686

Describe in detail the manner in which the well was plugged, indicating where the mud
fluid was placed and the method or methods used in introducing it into the hold. If cement
or other plugs were used, state the character of same and depth placed, from _____ feet
to _____ feet for each plug set.

Pump 20 sks. of cement from 2689 to 2439

Pump 35 sks. of cement from 1010 to 910

Pump 35 sks. of cement from 136 to 126

Put 35 sks. of cement from 40 to 0

Cut off & cap 8 5/8 3' below ground level

(If additional description is necessary, use BACK of this sheet)

Name of Plugging Contractor Sargents Casing Pulling Ser. Box 506 Liberal, Kansas 67901 Ks. No. 51

STATE OF _____ COUNTY OF _____, ss.

(employee of owner) or (owner or operator) of the
above-described well, being first duly sworn on oath, says: That I have knowledge of the
facts, statements, and matters herein contained and the log of the above-described well as
filed and that the same are true and correct. So help me God.

(Signature) _____

(Address) _____

SUBSCRIBED AND SWORN TO before me this _____ day of _____, 19 _____

Notary Public.

My Commission expires: _____

KANSAS

WELL COMPLETION REPORT AND DRILLER'S LOG

API No. 15 - 075 - 10062-0000
County Number

Operator
LADD PETROLEUM CORPORATION

Address
830 DENVER CLUB BLDG, DENVER, CO. 80202

Well No. 1721 Lease Name HCU


Footage Location
1980 feet from (S) line 1984 feet from (E) line

Principal Contractor Geologist
EARL F. WAKEFIELD

Spud Date Date Completed Total Depth P.B.T.D.
11/6/63 12/6/63 2715

Directional Deviation Oil and/or Gas Purchaser
NONE KANSAS NEBRASKA

S. 17 T. 22 R. 41 W
Loc. C-NW-SE
County HAMILTON

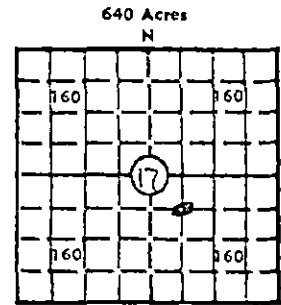

Elev.: Gr. 3614

DF KB

CASING RECORD

Report of all strings set— surface, intermediate, production, etc.

Purpose of string	Size hole drilled	Size casing set (in O.D.)	Weight lbs./ft.	Setting depth	Type cement	Sacks	Type and percent additives
SURFACE	12 1/4"	8 5/8"	20	136 FT	NEAT	110	3% HA-5
PRODUCTION		4 1/2"	9.5	2715 FT			

LINER RECORD

PERFORATION RECORD

Top, ft.	Bottom, ft.	Sacks cement	Shots per ft.	Size & type	Depth interval
					2687-89 FT

TUBING RECORD

Size	Setting depth	Packer set at
1 1/4"	2686	

ACID, FRACTURE, SHOT, CEMENT SQUEEZE RECORD

Amount and kind of material used	Depth interval treated

INITIAL PRODUCTION

Date of first production 4/64	Producing method (flowing, pumping, gas lift, etc.) Pumping
RATE OF PRODUCTION PER 24 HOURS	Oil — bbls. Gas 1410 MCF Water 20 bbls. Gas-oil ratio — CFPB
Disposition of gas (vented, used on lease or sold) Sold	Producing interval(s) Winfield

RECEIVED
STATE CORPORATION COMMISSION

MAY 5 1964
CONSERVATION DIVISION
Wichita, Kansas

INSTRUCTIONS: As provided in KCC Rule 82-2-125, within 90 days after completion of a well, one completed copy of this Drillers Log shall be transmitted to the State Geological Survey of Kansas, 4150 Monroe Street, Wichita, Kansas 67209. Copies of this form are available from the Conservation Division, State Corporation Commission, 245 No. Water, Wichita, Kansas 67202. Phone AC 316-522-2206. If confidential custody is desired, please note Rule 82-2-125. Drillers Logs will be on open file in the Oil and Gas Division, State Geological Survey of Kansas, Lawrence, Kansas 66044.

Operator

DESIGNATE TYPE OF COMP.: OIL, GAS, DRY HOLE, SWD, ETC.:

15-675-10062-0000

Well No.

1721

Lease Name

HCU

Gas

S 17 T 22 R 41 E

WELL LOG

Show all important zones of porosity and contents thereof; cored intervals, and all drill-stem tests, including depth interval tested, cushion used, time tool open, flowing and shut-in pressures, and recoveries.

SHOW GEOLOGICAL MARKERS, LOGS RUN, OR OTHER DESCRIPTIVE INFORMATION.

FORMATION DESCRIPTION, CONTENTS, ETC.

TOP

BOTTOM

NAME

DEPTH

Winfield 2681

RECEIVED
STATE CORPORATION COMMISSION
MAY - 5 1981

USE ADDITIONAL SHEETS, IF NECESSARY, TO COMPLETE WELL RECORD.

Date Received

Signature: Michael Wendling
Title: Production Engineer
Date: 3/27/81

REGISTRATION DIVISION
Wichita, Kansas