

STATE OF KANSAS
STATE CORPORATION COMMISSION

Give All Information Completely
Make Required Affidavit
Mail or Deliver Report to:
Conservation Division
State Corporation Commission
211 No. Broadway
Wichita, Kansas

WELL PLUGGING RECORD

Kearny County, Sec. 10 Twp. 22 Rge. (E) 35 (W)

Location as "NE/CNW/SW" or footage from lines 200'S and 200'W of C

Lease Owner Kansas-Nebraska Natural Gas Company, Inc.

Lease Name Rooney Well No. #4

Office Address 300 North St. Joseph Ave., Hastings, Nebraska

Character of Well (completed as Oil, Gas or Dry Hole) Gas

Date well completed July 13, 1953 1953

Application for plugging filed _____ 19____

Application for plugging approved _____ 19____


Plugging commenced _____ 19____

Plugging completed _____ 19____

Reason for abandonment of well or producing formation A leak in the casing allowed the Gloriette sand to fill the well to 1597 G.L.

If a producing well is abandoned, date of last production April 23 1959

Was permission obtained from the Conservation Division or its agents before plugging was commenced? yes

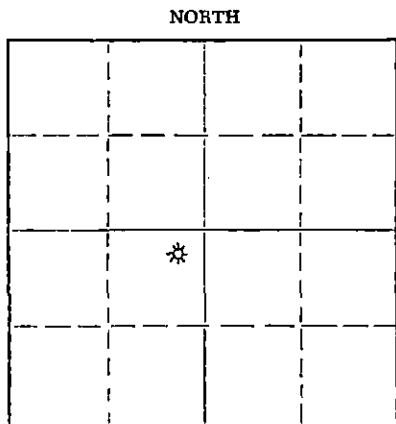

Locate well correctly on above Section Plat

Name of Conservation Agent who supervised plugging of this well M. A. Rives

Producing formation Herrington & Krider Depth to top 2632 Bottom 2664 Total Depth of Well 2719 Feet

Show depth and thickness of all water, oil and gas formations.

OIL, GAS OR WATER RECORDS

CASING RECORD

FORMATION	CONTENT	FROM	TO	SIZE	PUT IN	PULLED OUT
Hugoton Pay (herrington & krider)	Gas & Water	G.L.	303	10 3/4"	303 GL	None
		G.L.	2685	7"	2685 GL	None

Describe in detail the manner in which the well was plugged, indicating where the mud fluid was placed and the method or methods used in introducing it into the hole. If cement or other plugs were used, state the character of same and depth placed, from _____ feet to _____ feet for each plug set.

Well was originally sand filled to 1597 due to casing leak.
Dumped 5 gallon rock on bridge - total depth on bridge 1608.
Dumped 5 sacks of cement with bailer. Plug 1608 - 1572.
Filled hole with mud. Weight 11# per gallon. Viscosity 80 sec. per quart
Bridged hole at 300'. Dumped 5 gallons of rock.
Dumped 8 sacks of cement with bailer. Plug 300' to 265'.
Dumped 7 sacks of cement for top plug. Plug 45 to 10'.

RECEIVED
STATE CORPORATION COMMISSION
JUL 21 1959
CONSERVATION DIVISION
Wichita, Kansas

(If additional description is necessary, use BACK of this sheet)

Name of Plugging Contractor C. L. Hinds Drilling Co.

Address Ulysses, Kansas

STATE OF NEBRASKA COUNTY OF ADAMS, ss.
S. D. FORD, JR. (employee of owner) or (owner or operator) of the above-described

well, being first duly sworn on oath, says: That I have knowledge of the facts, statements, and matters herein contained and the log of the above-described well as filed and that the same are true and correct. So help me God.

(Signature) [Signature] S. D. FORD, JR.

Hastings Nebraska (Address)

SUBSCRIBED AND SWORN TO before me this 20th day of July 1959

My commission expires October 23, 1959 [Signature] Notary Public.

J. ROLAND MILLER

PLUGGING
FILE SEC 10 22 R3511
BOOK PAGE 52 LINE 27