


15-093.00649-0000

WELL PLUGGING RECORD

Give All Information Completely
Make Required Affidavit
Mail or Deliver Report to:
Conservation Division
State Corporation Commission
800 Biting Building
Wichita, Kansas

Kearny County. Sec. 23 Twp. 22 Rge. 37 (E) W (W)
Location as "NE/CNW/SW" or footage from lines NE NE NE
Lease Owner Trans Era Petroleum, Inc.
Lease Name Miller "E" Well No. 1
Office Address Russell, Kansas
Character of Well (completed as Oil, Gas or Dry Hole) Dry Hole
Date well completed 8/2/53 19
Application for plugging filed 8/21/53 19
Application for plugging approved 8/21/53 19
Plugging commenced 8/22/53 19
Plugging completed 8/27/53 19
Reason for abandonment of well or producing formation Dry Hole

NORTH

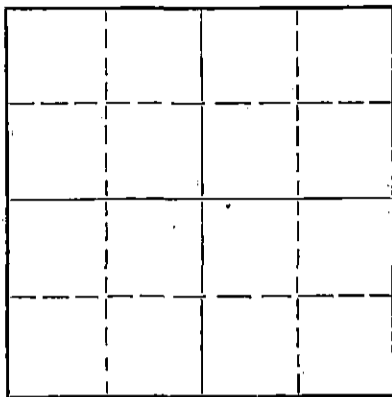

Locate well correctly on above
Section Plat

If a producing well is abandoned, date of last production 19
Was permission obtained from the Conservation Division or its agents before plugging was commenced? Yes

Name of Conservation Agent who supervised plugging of this well M. A. Rives
Producing formation _____ Depth to top _____ Bottom _____ Total Depth of Well 5180 Feet
Show depth and thickness of all water, oil and gas formations.

OIL, GAS OR WATER RECORDS

CASING RECORD

FORMATION	CONTENT	FROM	TO	SIZE	PUT IN	PULLED OUT
				8 5/8"	237	None
				5 1/2"	2835	1018

Describe in detail the manner in which the well was plugged, indicating where the mud fluid was placed and the method or methods used in introducing it into the hole. If cement or other plugs were used, state the character of same and depth placed, from _____ feet to _____ feet for each plug set.

PLUGGING RECORD

Plugged back with crushed rock to 2640', dumped 5 sax cement at 2640' with dump bailer.
Top of cement 2605'. Filled with mud to 235', set rock bridge, dumped 20 sacks cement
Top of cement, 175'. Filled with mud to 35', set rock bridge, dumped 10 sax cement for cap.

(If additional description is necessary, use BACK of this sheet)

Name of Plugging Contractor J & M Casing Pulling Co.
Address Great Bend, Kansas

STATE OF KANSAS, COUNTY OF RUSSELL, ss.
H. R. Michaelis (employee of owner) or (owner or operator) of the above-described well, being first duly sworn on oath, says: That I have knowledge of the facts, statements, and matters herein contained and the log of the above-described well as filed and that the same are true and correct. So help me God.

(Signature) H. R. Michaelis
Russell, Kansas
(Address)

SUBSCRIBED AND SWORN to before me this 10th day of September, 19 53

My commission expires 1-30-57.

Margie Cooper Notary Public.

24-7388-6 3-53-20M

PLUGGING
FILE SEC 23 T 22 R 37W
BOOK PAGE 121 LINE 34

RECEIVED
STATE CORPORATION COMMISSION
SEP 11 1953
9-11-53
CONSERVATION DIVISION
Wichita, Kansas

15-093-06649-0000

Trans Era Petroleum, Inc.
Miller #1 #1

NE NE NE 23-22-37
Kearny County, Ks.

Total Depth 5180'

Comm. 7/6/53

Comp. 9/2/53

Casing

Cement

3 5/8" Set @ 237'
3 1/2" Set @ 2935'

150 sacks Ash Grove
100 sacks Portland

Formation

Depth

Sand	160
Sand-gravel	170
Clay	200
Blue Shale	232
Shale	445
Sand	530
Sand-shale	600
Sandy lime	730
Pyrite	790
Pyrite-shale	990
Red bed	1340
Red bed-shale	1390
Anhydrite	1405
Anhydrite-shale	1475
Anhydrite	1493
Sand-red bed	1600
Red bed-shale	1900
Red bed	2100
Red bed-shale	2140
Shale	2170
Lime-shale	2245
Lime	2326
Shale	2440
Lime	2565
Lime-shale	2675
Lime	2875
Lime-shale	3030
Lime	3290
Red bed	3360
Lime	4140
Lime-sand	4158
Lime	4230
Sand	4245
Lime	4753
Lime-chert	4857
Lime-shale	4930
Lime	5035
Lime-shale	5070
Lime	5092
Lime-shale	5123
Lime	5180'

NOTARY PUBLIC
STATE OF KANSAS
MARGIE COOPER
COMM. EXPIRES 1-30-57

STATE OF KANSAS }
RUSSELL COUNTY } ss

I hereby certify that the above information is true and correct to
the best of my knowledge.

Margie Cooper

Subscribed and sworn to before me this 7th day of August, 1953.

Margie Cooper
Notary Public

23 22 370
12-11-54

My commission expires 1-30-57.