


STATE OF KANSAS
STATE CORPORATION COMMISSION

Give All Information Completely
Make Required Affidavit
Mail or Deliver Report to
Conservation Division
State Corporation Commission
245 North Water
Wichita, KS 67202

FORM CP-4

WELL PLUGGING RECORD

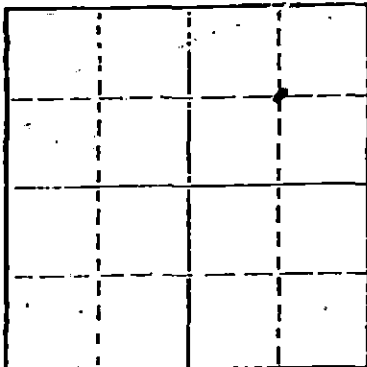

Locate well correctly on above
Section Plat

Kearny County, Sec. 11 Twp. 22 Rge. (E) 38 (W)
Location as "NE/CNWSW" or footage from lines C - NE/4
Lease Owner Nadel and Gussman
Lease Name Withroder Well No. 1
Office Address 32nd Floor-First National Tower-Tulsa, OK 74103
Character of Well (completed as Oil, Gas or Dry Hole) Dry Hole
Date well completed October 8 19 81
Application for plugging filed (paper) October 9 19 81
Application for plugging approved (verbal) October 8 19 81
Plugging commenced October 8 19 81
Plugging completed October 8 19 81
Reason for abandonment of well or producing formation No pressure buildup;
no increase in gas
If a producing well is abandoned, date of last production 19
Was permission obtained from the Conservation Division or its agents before plugging was com-
menced? yes - Clarence Thomas, Jr.

Name of Conservation Agent who supervised plugging of this well (same as above)
Producing formation Depth to top Bottom Total Depth of Well 3075 Feet
Show depth and thickness of all water, oil and gas formations.

OIL, GAS OR WATER RECORDS

CASING RECORD

FORMATION	CONTENT	FROM	TO	SIZE	PUT IN	PULLED OUT
Herrington	water, gas	2624	2638			
Winfield	water	2696	2750			
Ft. Riley	water	2758	2852			
Wreford	tight water	2862	2870			
Council Grove	water, gas	2874	3036			

Describe in detail the manner in which the well was plugged, indicating where the mud fluid was placed and the method or methods used in introducing it into the hole. If cement or other plugs were used, state the character of same and depth placed, from feet to feet for each plug set.

Pumped 25 sacks Class A + 4% CaCl followed by 275 sacks Class A cement down 5-1/2" casing, as directed by Clarence Thomas, Jr.

10-22-81
RECEIVED
STATE CORPORATION COMMISSION
OCT 22 1981
CONSERVATION DIVISION
Wichita, Kansas

Name of Plugging Contractor Dowell
Address Ulysses, Kansas
(If additional description is necessary, use BACK of this sheet)

STATE OF OKLAHOMA COUNTY OF TULSA ss.
M. R. Taylor, Mgr. of Production (employee of owner) or (owner or operator) of the above-described

well, being first duly sworn on oath, says: That I have knowledge of the facts, statements, and matters herein contained and the log of the above-described well as filed and that the same are true and correct. So help me God.

(Signature) M. R. Taylor
Nadel and Gussman
32nd Floor-First National Tower-Tulsa, OK 74103
(Address)

Subscribed and sworn to before me this 20th day of October 19 81

My commission expires May 11, 1983
Mildred Carter
Notary Public.

NADEL AND GUSSMANWITHRODER WELL NO. 1
KEARNY COUNTY, KANSAS

OPERATION COMMENCED: 8/20/81

OPERATION COMPLETED: 8/25/81

DRILLERS LOG

8/20	0 - 370	Sand, Gyp.
8/21	370 - 1200	Sand, Gyp., Shale
8/22	1200 - 1840	Sand, Shale, Lime
8/23	1840 - 2523	Shale, Lime
8/24	2523 - 2947	Shale, Lime
8/25	2947 - 3070	Shale, Lime

CASING

8/20	Ran 10 jts. 8 5/8" csg.
8/26	Ran 73 jts. 5 1/2" 14# csg., cemented with 500 sks. light and 150 sks. class H.

RECEIVED
STATE CORPORATION COMMISSION

OCT 14 1981

CONSERVATION DIVISION
Wichita, Kansas