

STATE OF KANSAS
STATE CORPORATION COMMISSION


WELL PLUGGING RECORD

Give All Information Completely
Make Required Affidavit
Mail or Deliver Report to:
Conservation Division
State Corporation Commission
800 Bitting Building
Wichita, Kansas

OR
FORMATION PLUGGING RECORD

Strike out upper line
when reporting plugging
of formations.

NORTH

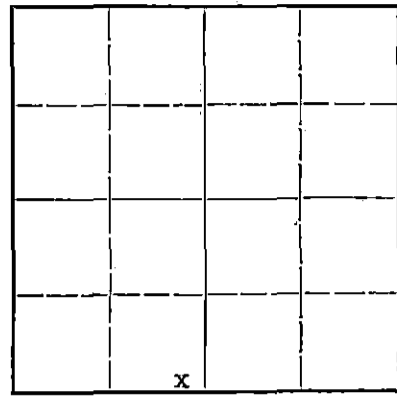

Locate well correctly on above
Section Plat

Stafford County. Sec. 13 Twp. 24 Rge. II (E) W (W)
Location as "NE $\frac{1}{4}$ NW $\frac{1}{4}$ SW $\frac{1}{4}$ " or footage from lines SE-SE-SW
Lease Owner MABEE OIL & GAS CO.
Lease Name Ira Johnson Well No. 8
Office Address Box # 28 Zenith Kansas
Character of Well (completed as Oil, Gas or Dry Hole) Oil & Gas
Date well completed II- 21 19 38
Application for plugging filed Aug. 22 19 45
Application for plugging approved Aug. 23 19 45
Plugging commenced Sept. 9 19 45
Plugging completed Sept. 17 19 45
Reason for abandonment of well or producing formation Oil exhausted

If a producing well is abandoned, date of last production Aug. 20 19 45
Was permission obtained from the Conservation Division or its agents before plugging was commenced? Yes

Name of Conservation Agent who supervised plugging of this well H.W. Kerr
Producing formation Viola Lime Depth to top 3,805 Bottom 3,813 Total Depth of Well 3,813 Feet
Show depth and thickness of all water, oil and gas formations.


OIL, GAS OR WATER RECORDS

CASING RECORD

Formation	Content	From	To	Size	Put In	Pulled Out
Lansing Lime		3,395	3,435			
Misener	Oil & Gas	3,795	3,805			
Viola Lime	Oil & Gas	3,805	3,813	7" O. D.	3,788	2,818

Describe in detail the manner in which the well was plugged, indicating where the mud fluid was placed and the method or methods used in introducing it into the hole. If cement or other plugs were used, state the character of same and depth placed, from _____ feet to _____ feet for each plug set.

10 Sacks cement from 3,813 to 3,775
Heavy mud from 3,775 to 260'
10 sacks cement and rock bridge from 260' to 250'
Heavy mud from 250' to 18'
10 sacks cement from 18' to cellar base for cap

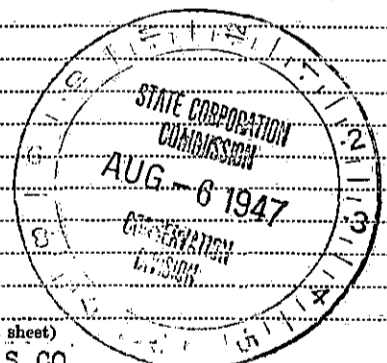

(If additional description is necessary, use BACK of this sheet)

Correspondence regarding this well should be addressed to MABEE OIL & GAS CO.
Address Box # 28 Zenith, Kansas

STATE OF Kansas, COUNTY OF Stafford, ss.
H.A. Marks (employee of owner) or (owner or operator) of the above-described well,
being first duly sworn on oath, says: That I have knowledge of the facts, statements, and matters herein contained and the log of the above-described well as filed and that the same are true and correct. So help me God.

(Signature) H.A. Marks
Box 28 Zenith, Kansas (Address)

SUBSCRIBED AND SWORN to before me this 1 day of Aug, 19 47

My commission expires April 6 - 1951

Notary Public
PLUGGING
FILE SEC 13 T 24 R 11W
BOOK PAGE 24 LINE 9