

15.185-10269-0000

STATE OF KANSAS
STATE CORPORATION COMMISSION

WELL PLUGGING RECORD

Give All Information Completely
No. Required Affidavit
Mail or Deliver Report to:
Conservation Division
State Corporation Commission
800 Bittling Building
Wichita, Kansas

FORMATION PLUGGING RECORD

Strike out upper line
when reporting plug-
ging off formations.

NORTH

		X	

Locate well correctly on above
Section Plat

Stafford County. Sec. 13 Twp. 24 Rge. II (E) V (W)
 Location as "NE $\frac{1}{4}$ NW $\frac{1}{4}$ SW $\frac{1}{4}$ " or footage from lines NW-NW-SE
 Lease Owner MABEE OIL & GAS CO.
 Lease Name Cleo Johnson Well No. 7
 Office Address Box # 28 Zenith, Kansas
 Character of Well (completed as Oil, Gas or Dry Hole) Oil & Gas
 Date well completed Dec. 16, 1938
 Application for plugging filed Nov. 7, 1946
 Application for plugging approved Nov. 8, 1946
 Plugging commenced Mar. 18, 1947
 Plugging completed Mar. 28, 1947
 Reason for abandonment of well or producing formation Oil exhausted

If a producing well is abandoned, date of last production Mar. 17, 1947
 Was permission obtained from the Conservation Division or its agents before plugging was com-
 menced? Yes

Name of Conservation Agent who supervised plugging of this well H.W. Kerr
 Producing formation Viola Lime Depth to top 3,798 Bottom 3,815 Total Depth of Well 3,815 Feet
 Show depth and thickness of all water, oil and gas formations.


OIL, GAS OR WATER RECORDS

CASING RECORD

Formation	Content	From	To	Size	Put In	Pulled Out
Lansing Lime		3.375	3.430			
Misener		3.775	3.798			
Viola Lime	Oil & Gas	3.798	3.815	7" O.D.	3.776	2.680

Describe in detail the manner in which the well was plugged, indicating where the mud fluid was placed and the method or methods used in introducing it into the hole. If cement or other plugs were used, state the character of same and depth placed, from _____ feet to _____ feet for each plug set.

9 Sacks cement from 3,815 to 3,770
 Fill with mud from 3,770 to 250
 15 sacks cement and rock bridge set at 250 to 235
 Fill with mud from 235 to 20'
 10 Sacks cement from 20' to cellar base for cap.

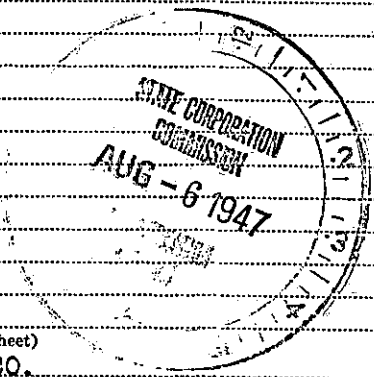

(If additional description is necessary, use BACK of this sheet)

Correspondence regarding this well should be addressed to MABEE OIL & GAS CO.
 Address Box # 28 Zenith, Kansas

STATE OF Kansas, COUNTY OF Stafford, ss.
 H.A. Marks (employee of owner) or (owner or operator) of the above-described well,
 being first duly sworn on oath, says: That I have knowledge of the facts, statements, and matters herein contained and the log of the above-described well as filed and that the same are true and correct. So help me God.

(Signature) H.A. Marks
 Box 28 Zenith, Kansas
 (Address)

SUBSCRIBED AND SWORN TO before me this 1 day of Aug, 1947

My commission expires April 6-1951
 J. E. Hartnett Notary Public.

21-871-8 9-45-6M

